

THE GABLES  
BOX HILL  
PRECINCT B

STAGE 3D  
PRESSURE SEWER & RECYCLED WATER




LOCALITY PLAN  
(NOT TO SCALE)

DRAWING LIST	
SHEET 1	COVER SHEET
SHEET 2	GENERAL NOTES
SHEET 3	PRESSURE SEWER GENERAL ARRANGEMENT
SHEET 4	PRESSURE SEWER DETAIL PLAN
SHEET 5	COLLECTION TANK LEVEL DETAILS
SHEET 6	RECYCLED WATER GENERAL ARRANGEMENT
SHEET 7	RECYCLED WATER DETAIL PLAN

02	WORK-AS-CONSTRUCTED	D.S.	1/4/22
01	ORIGINAL ISSUE FOR APPROVAL	D.S.	1/2/21
No.	REVISION DESCRIPTION	BY	DATE

SERVICE	DATE	REF.	WORK-AS-CONSTRUCTED CERTIFICATION
			DEVELOPER: STOCKLAND DEVELOPMENT Pty. Ltd.
			PROJECT SUPERVISOR: ROSE ATKINS RIMMER (INFRASTRUCTURE) Pty. Ltd.
			CONSTRUCTOR: FLUID SERVICES
			COMPLETED: W.A.C. PREPARED: 1/4/2022

ROSE ATKINS RIMMER (Infrastructure) Pty. Ltd.



WATER RELATED INFRASTRUCTURE DESIGN AND MANAGEMENT

SHOP 7 & 8 'M CENTRE'

40 STERLING ROAD, MINCHINBURY NSW 2770

PH: (02) 9853 0200 FAX: (02) 9671 7399



Quality Standard  
Endorsed  
Company

CLIENT:



altogether.

TITLE:

PLAN OF PROPOSED WATER INFRASTRUCTURE SERVICES  
THE GABLES DEVELOPMENT - PRECINCT B (STAGE 3D)  
VALETTA DRIVE, GABLES  
L.G.A. THE HILLS

COVER SHEET

DRAWN BY: D.SHEATHER	DESIGNED BY: D.SHEATHER	REVIEWED BY: K.GAO	VERIFIED BY: K.GAO
SCALE: -	DATAN: -	U.S.D. REFERENCE: 88 H15	DATE OF ISSUE: 1/4/2022

SHEET 1 OF 7

VERSION:  
WAC

4/23645/B3D



SEWER NOTES

1. ALL WORKS SHALL BE CONSTRUCTED IN ACCORDANCE WITH THE DESIGN DRAWINGS, ALTOGETHER GROUP SUPPLEMENTARY MANUAL TO W.S.A.A., PRESSURE SEWERAGE CODE OF AUSTRALIA WSA 07-2007 VERSION 1.1& POLYETHYLENE PIPELINE CODE WSA 01-2004.
2. ALL EQUIPMENT, MATERIALS & ACCESSORIES USED IN THIS CONTRACT SHALL BE NEW & SHALL COMPLY WITH ALTOGETHER GROUP REQUIREMENTS. BUTT FUSION FITTINGS DENOTED HEREWITH HAVE BEEN DERIVED FROM THE GEORG FISCHER PIPING SYSTEMS BUTT FUSION PRODUCT RANGE. ELECTROFUSION FITTINGS DENOTED HEREWITH HAVE BEEN DERIVED FROM THE PLASSON POLYETHYLENE PIPING SYSTEMS PRODUCT RANGE.
3. ALL SERVICES SHOWN ARE INDICATIVE ONLY. A CURRENT SERVICES SEARCH & SITE CHECK OF ALL EXISTING SERVICES WILL BE REQUIRED PRIOR TO COMMENCEMENT OF ANY WORKS. THE CONSTRUCTOR IS TO DETERMINE LEVELS & LOCATIONS EXISTING SERVICES IN THE VICINITY OF THE CONSTRUCTION SITE AND ANY CONSTRUCTED STRUCTURES FOR PROPOSED SERVICES, SUCH AS DUCTING FOR WATER OR ELECTRICITY WITHIN THE SUBDIVISION. THE CONTRACTOR MUST ENSURE ALL SERVICES ARE LOCATED BY THE RELEVANT AUTHORITY PRIOR TO COMMENCEMENT OF WORKS.
4. PRESSURE SEWER MAINS SHALL BE BLACK POLYETHYLENE (PE100 PN16) WITH A CREAM STRIPE AS PER WSA 07-2007 & ALTOGETHER GROUP SUPPLEMENTARY MANUAL TO W.S.A.A.
5. ALL POLYETHYLENE MAINS <DN200 SHALL BE JOINED BY ELECTROFUSION TECHNIQUES IN ACCORDANCE WITH THE MANUFACTURERS REQUIREMENTS. ALL POLYETHYLENE MAINS >DN200 SHALL BE JOINED BY BUTTWELDED TECHNIQUES IN ACCORDANCE WITH THE MANUFACTURERS REQUIREMENTS
6. MAIN TO BE LAID GENERALLY AS INDICATED IN SERVICE ALLOCATION DIAGRAMS. INSTRUCTION NOTES SHALL TAKE PRECEDENCE OVER DIAGRAMS WHERE PROVIDED. 600mm HORIZONTAL CLEARANCE TO BE MAINTAINED BETWEEN ALL SEWER & WATER MAINS. MINIMUM PIPE COVER SHALL BE 800mm IN FOOTWAYS & FOR ROADWAYS. MAXIMUM PIPE COVER SHALL GENERALLY BE 15m. WHERE COVER FOR A TRENCHED INSTALLATION EXCEEDS 15m, BUT LESS THAN 25m, THE MAIN AS A MINIMUM SHALL BE EMBEDDED IN STABILISED SAND. THE CONTRACTOR SHALL ENSURE THAT ALL PRESSURE SEWER & RECYCLED WATER MAINS HAVE SUFFICIENT VERTICAL SEPARATION AS PER THE CLEARANCE TABLE ADJACENT.
7. MAINS CROSSING UNDER EXISTING DRIVEWAYS (SEALED, PAVED OR DECORATIVE) SHALL BE CONDUCTED BY UNDER BORING ONLY UNLESS PERMISSION IS GRANTED BY THE AFFECTED PROPERTY OWNER.
8. MAINS WITHIN 2m OF ELECTRICITY OR POWER POLES SHALL BE CONDUCTED BY BORING TECHNOLOGY (UNLESS AGREED TO BY THE BOX HILL WATER REPRESENTATIVE).
9. ALL PIPE BEDDING MATERIAL SHALL COMPLY WITH WSAA PRODUCT SPECIFICATION WSA-PS350 & WSA-PS351.
10. ALL BENDS SHALL BE ELECTROFUSION OR BUTTWELDED SWEEP BENDS. FABRICATED BENDS SHALL NOT BE USED IN LIEU. KNUCKLE ELBOWS ARE NOT PERMITTED.
11. MINIMUM BENDING RADIUS FOR PN16 PE100 (SDR11) SHALL BE 20 x DN (ie. DN400 R8.0m, DN250 R5.0m, DN200 R4.0m, DN160 R3.2m, DN125 R2.5m, DN90 R1.8m, DN75 R1.5m, DN63 R1.3m, DN50 R1.0m, DN40 R0.8m
12. ALL HOUSE SERVICE LATERALS SHALL BE DN40 (PE100 PN16) .
13. FLUSHING PITS SHALL CONFORM WITH ALTOGETHER GROUP STANDARD DRAWINGS. REFER TO WEBSITE FOR CURRENT VERSION.  
SMALL MAINS (<DN110)  
[https://information.altogethergroup.com.au/governance/Land\\_Housing/PSS-1017A-FS.pdf](https://information.altogethergroup.com.au/governance/Land_Housing/PSS-1017A-FS.pdf)  
LARGE MAINS (>DN110)  
[https://information.altogethergroup.com.au/governance/Land\\_Housing/PSS-1017B-FS.pdf](https://information.altogethergroup.com.au/governance/Land_Housing/PSS-1017B-FS.pdf)
14. LOCALISED DEEPENING OF MAINS MAY BE REQUIRED TO FACILITATE AIR VALVE INSTALLATION. THE CONTRACTOR SHALL ENSURE THAT THE AIR VALVE OFFTAKE IS LOCATED AT A HIGH POINT (NATURAL OR ARTIFICIAL) IN THE MAIN (i.e. MAIN SHALL GRADE DOWNWARDS EITHER SIDE OF THE AIR VALVE).
15. DETECTABLE MARKING TAPE SHALL BE LAID ON TOP OF THE PIPE EMBEDMENT MATERIAL BEFORE BACKFILLING & CONNECTED TO SURFACE VALVES.
16. ALL SURFACE FITTINGS LOCATED IN TRAFFICABLE AREAS (ie ROADWAYS, PATHS etc) SHALL HAVE HEAVY DUTY SURROUNDS INSTALLED.
17. DURING CONSTRUCTION, ALL OPEN ENDS OF PIPE SHALL BE CAPPED OFF TO PREVENT ENTRY OF FOREIGN MATTER.
18. ALL VALVES SHALL BE RESILIENT SEATED SLUICE VALVES (CLOCKWISE CLOSING), SHALL BE RESTRAINED IN ACCORDANCE WITH WAT-1207 & SHALL COMPLY WITH ALTOGETHER GROUP STANDARD DRAWING PSS-1015-FS.
19. ALL MAINS SHALL BE TESTED IN ACCORDANCE WITH WSA 07-2007 Version 1.1.
20. FOR LOTS WITH TANKS IN THE REAR: 1 x 25mm INSTRUMENTATION CONDUIT (ORANGE) AND 1 x 25mm ELECTRICAL CONDUIT (ORANGE) (WITH DRAW WIRES) SHALL BE INSTALLED FROM THE COLLECTION TANK TO WATER METERS. THE CONDUITS SHALL BE LAID IN A COMMON TRENCH WITH THE SEWERAGE AND MAINTAIN A MINIMUM HORIZONTAL CLEARANCE OF 400mm.
21. THE CONSTRUCTOR SHALL PROVIDE BOX HILL WATER WITH MINIMUM OF 7 DAYS NOTICE IN WRITING OF INTENT TO CONNECT NEW MAINS TO EXISTING INFRASTRUCTURE. CONNECTIONS ARE NOT PERMITTED UNTIL COMPLIANT TEST RESULTS HAVE BEEN PROVIDED & CONFIRMATION IS PROVIDED BY THE BOX HILL WATER REPRESENTATIVE.
22. UPON COMPLETION OF WORKS, ALL SURFACES MUST BE RESTORED AS CLOSE AS POSSIBLE, TO THE CONDITION THAT EXISTED PRIOR TO COMMENCEMENT OF WORK.
23. PERMISSION OF ENTRY MUST BE OBTAINED BY THE CONTRACTOR FROM THE OWNER/OCCUPIER PRIOR TO COMMENCEMENT OF WORK IN PRIVATE PROPERTY.
24. BURIED FITTINGS ARE NOT TO BE BACKFILLED UNTIL W.A.C. DETAILS HAVE BEEN OBTAINED & APPROVAL FOR BACKFILLING GIVEN BY THE BOX HILL WATER REPRESENTATIVE. THE CONTRACTOR SHALL PROVIDE M.G.A. COORDINATED WORK-AS-CONSTRUCTED INFORMATION REGARDING THE INSTALLATION OF ALL BURIED FITTINGS.
25. THE MINIMUM NUMBER OF COMPACTION TESTS REQUIRED TO SATISFY THE PRESSURE SEWER CODE OF AUSTRALIA (CLAUSE 213.4) ARE:  
TRAFFICABLE:  
PIPE EMBEDMENT ZONE: NIL TRENCH FILL ZONE: 1 TEST / CROSSING (3 Tests)  
NON-TRAFFICABLE:  
PIPE EMBEDMENT ZONE: NIL TRENCH FILL ZONE: 1 TEST / 100m (6 Tests)
26. BOUNDARY KITS (COMPLETE) SHALL BE NONE SUPPLIED. COLLECTION TANKS SHALL BE INSTALLED WITH BOUNDARY KIT (REFER ALTOGETHER GROUP STANDARD DRAWINGS PSS-1112-FS & PSS-1113-FS). PUMP TO BE INSTALLED BY OTHERS.
27. ALL MAINS (UP TO THE BOUNDARY KIT) SHALL BE PRESSURE TESTED TO 1600 kPa.
28. ALL MAINS SHALL BE FLUSHED WITH WATER TO REMOVE ANY DEBRIS PRIOR TO COMMISSIONING.
29. SURFACE IDENTIFICATION MARKERS ARE TO BE PROVIDED TO BOX HILL WATER REQUIREMENTS.
30. ROPE OFF ALL PRESSURE SEWER UNITS & FLUSHING POINTS TO LIMIT DAMAGE DURING CONSTRUCTION.
31. PRESSURE TRANSMITTER TO BE MEASUREX MRB21 GENERAL PURPOSE TRANSMITTER WITH MICROSPIDER LOGGING TELEMETRY AND ALARM PER ALTOGETHER GROUP REQUIREMENTS.
32. WORK-AS-CONSTRUCTED DOCUMENTATION SHALL BE PROVIDED BY THE CONTRACTOR STRICTLY IN ACCORDANCE WITH THE ALTOGETHER GROUP Q.A. SUBMISSION CHECKLIST.

RECYCLED WATER NOTES

1. ALL WORKS SHALL BE CONSTRUCTED IN ACCORDANCE WITH THE DESIGN DRAWINGS, ALTOGETHER GROUP SUPPLEMENTARY MANUAL TO W.S.A.A. & WSA 03-2011-3.1 (SYDNEY WATER WATER EDITION - 2014).
2. POTABLE WATER SHALL BE UTILISED FOR FIRE FIGHTING PURPOSES.
3. ALL EQUIPMENT, MATERIALS & ACCESSORIES USED IN THIS CONTRACT SHALL BE NEW, SHALL CONFORM WITH THE APPROPRIATE CURRENT AUSTRALIAN STANDARDS & SHALL COMPLY WITH ALTOGETHER GROUP REQUIREMENTS.
4. ALL SERVICES SHOWN ARE INDICATIVE ONLY. A CURRENT SERVICES SEARCH & SITE CHECK OF ALL EXISTING SERVICES WILL BE REQUIRED PRIOR TO COMMENCEMENT OF ANY WORKS. THE CONSTRUCTOR IS TO DETERMINE LEVELS & LOCATIONS EXISTING SERVICES IN THE VICINITY OF THE CONSTRUCTION SITE AND ANY CONSTRUCTED STRUCTURES FOR PROPOSED SERVICES, SUCH AS DUCTING FOR WATER OR ELECTRICITY WITHIN THE SUBDIVISION. THE CONTRACTOR MUST ENSURE ALL SERVICES ARE LOCATED BY THE RELEVANT AUTHORITY PRIOR TO COMMENCEMENT OF WORKS.
5. THE CONSTRUCTOR SHALL VERIFY WITH THE SITE SURVEYOR THE POSITION & LEVEL OF ALL EXISTING & PROPOSED BOUNDARIES PERTINENT TO THE INFRASTRUCTURE INSTALLATIONS.
6. MAINS TO BE LAID GENERALLY AS INDICATED IN SERVICE ALLOCATION DIAGRAMS. INSTRUCTION NOTES SHALL TAKE PRECEDENCE OVER DIAGRAMS WHERE PROVIDED. 600mm HORIZONTAL CLEARANCE TO BE MAINTAINED BETWEEN ALL SEWER & WATER MAINS. MINIMUM PIPE COVER SHALL BE 600mm IN FOOTWAYS (TYPE B EMBEDMENT: WAT-1202-VI) & FOR ROADWAYS (TYPE L EMBEDMENT: WAT-1204-VI). MAXIMUM PIPE COVER SHALL GENERALLY BE 15m. WHERE COVER FOR A TRENCHED INSTALLATION EXCEEDS 15m, BUT IS LESS THAN 25m, THE MAIN AS A MINIMUM SHALL BE EMBEDDED IN STABILISED SAND. THE CONTRACTOR SHALL ENSURE THAT ALL RECYCLED WATER & PRESSURE SEWER MAINS HAVE SUFFICIENT VERTICAL SEPARATION AS PER THE CLEARANCE TABLE ADJACENT.
7. ALL RECYCLED WATER MAINS SHALL BE LILAC mPVC (PN16). DIFFERENTIATION OF POTABLE & RECYCLED WATER SYSTEMS SHALL BE AS PER TABLE 4.1 WSA03-2011 WITH BOTH SERVICES BEING CLASSIFIED AS WATERMAINS. RECYCLED WATER MAINS SHALL ALWAYS BE LOWER THAN POTABLE MAINS. 150mm VERTICAL CLEARANCE BETWEEN POTABLE WATER & RECYCLED WATER MAINS SHALL BE PROVIDED.
8. MAXIMUM JOINT DEFLECTION SHALL BE IN ACCORDANCE WITH THE MANUFACTURERS RECOMMENDATIONS.
9. LOCALLY LOWER PIPEWORK IN VICINITY OF STOP VALVES TO ENSURE SUFFICIENT COVER IS MAINTAINED OVER VALVES. LOWERING OF PIPEWORK SHALL ACHIEVED OVER A NUMBER OF PIPE LENGTHS EITHER SIDE OF VALVES TO ELIMINATE ANY SHARP DEFLECTIONS.
10. ALL PIPE BEDDING MATERIAL SHALL COMPLY WITH WSAA PRODUCT SPECIFICATION PS-350, 368 & 369. GEOTECHNICAL CONDITIONS SHOULD BE ASSESSED DURING CONSTRUCTION BY THE CONTRACTOR IN ASSOCIATION WITH THE BOX HILL WATER REPRESENTATIVE TO DETERMINE THE NEED TO MODIFY EMBEDMENT/TRENCHFILL TYPE & THE ROAD FOR TRENCH DRAINAGE/BULKHEADS.
11. DURING CONSTRUCTION, ALL OPEN ENDS OF PIPES SHALL BE CAPPED OFF TO PREVENT ENTRY OF FOREIGN MATTER.
12. HYDRANTS, STOP VALVES & ALL OTHER FITTINGS SHALL BE THE SAME SIZE AS THROUGH WATER MAIN & ANTICLOCKWISE CLOSING.
13. HYDRANTS MUST NOT BE INSTALLED IN POTENTIAL DRIVEWAY LOCATIONS. HYDRANTS & WATER SERVICES SHALL BE NOMINALLY AT LEAST 5m FROM EACH BOUNDARY OR ON BOUNDARIES. WHERE POSSIBLE, FITTINGS SHALL BE LOCATED BEHIND KERB INLET PITS.
14. THRUST BLOCKS SHALL BE INSTALLED IN ACCORDANCE WITH WAT-1205.
15. ALL PROPERTY (MAIN TO METER) SERVICE CONNECTIONS SHALL BE CONSTRUCTED STRICTLY IN ACCORDANCE ALTOGETHER GROUP REQUIREMENTS. REFER TO ALTOGETHER GROUP WEBSITE FOR CURRENT VERSIONS.  
SINGLE SERVICE  
[https://information.altogethergroup.com.au/governance/Land\\_Housing/WAT-1854-FS.pdf](https://information.altogethergroup.com.au/governance/Land_Housing/WAT-1854-FS.pdf)  
DUAL SERVICE  
[https://information.altogethergroup.com.au/governance/Land\\_Housing/WAT-1855-FS.pdf](https://information.altogethergroup.com.au/governance/Land_Housing/WAT-1855-FS.pdf)
16. PROPERTY SERVICE CONNECTIONS SHALL BE FLUSHED & LOCKED (BY THE BOX HILL WATER REPRESENTATIVE) FOLLOWING SUCCESSFUL PRESSURE TESTING.
17. SURFACE FITTINGS LOCATED IN TRAFFICABLE AREAS (ie ROADWAYS, PATHS etc) SHALL HAVE HEAVY DUTY SURROUNDS INSTALLED.
18. ALL MAINS SHALL BE TESTED IN ACCORDANCE WITH WSA 03-2011-3.1 (SYDNEY WATER EDITION - 2014).
19. ALL MAINS SHALL BE FLUSHED WITH WATER TO REMOVE ANY DEBRIS PRIOR TO COMMISSIONING.
20. WATER QUALITY TESTING SHALL BE IN ACCORDANCE WITH WSA 03-2011-3.1 (SYDNEY WATER EDITION - 2014; CLAUSE 19.7).
21. THE CONSTRUCTOR SHALL PROVIDE BOX HILL WATER WITH MINIMUM OF 7 DAYS NOTICE IN WRITING OF INTENT TO CONNECT NEW MAINS TO EXISTING INFRASTRUCTURE. CONNECTIONS ARE NOT PERMITTED UNTIL COMPLIANT TEST RESULTS HAVE BEEN PROVIDED & CONFIRMATION IS PROVIDED BY THE BOX HILL WATER REPRESENTATIVE.
22. UPON COMPLETION OF WORKS, ALL SURFACES MUST BE RESTORED AS CLOSE AS POSSIBLE, TO THE CONDITION THAT EXISTED PRIOR TO COMMENCEMENT OF WORK.
23. PERMISSION OF ENTRY MUST BE OBTAINED BY THE CONTRACTOR FROM THE OWNER/OCCUPIER PRIOR TO COMMENCEMENT OF WORK IN PRIVATE PROPERTY.
24. BURIED FITTINGS ARE NOT TO BE BACKFILLED UNTIL W.A.C. DETAILS HAVE BEEN OBTAINED & APPROVAL FOR BACKFILLING GIVEN BY THE BOX HILL WATER REPRESENTATIVE. THE CONTRACTOR SHALL PROVIDE M.G.A. COORDINATED WORK-AS-CONSTRUCTED INFORMATION REGARDING THE INSTALLATION OF ALL BURIED FITTINGS.
25. THE MINIMUM NUMBER OF COMPACTION TESTS REQUIRED TO SATISFY THE WATER SUPPLY CODE OF AUSTRALIA ARE:  
TRAFFICABLE:  
PIPE EMBEDMENT ZONE: NIL TRENCH FILL ZONE: 1 TEST / CROSSING (3 Tests)  
NON-TRAFFICABLE:  
PIPE EMBEDMENT ZONE: NIL TRENCH FILL ZONE: 1 TEST / 100m (6 Tests)  
  
TESTING SHALL BE IN ACCORDANCE WITH TABLE 16.1 & 17.1 OF THE WATER SUPPLY CODE OF AUSTRALIA
26. SURFACE IDENTIFICATION MARKERS ARE TO BE PROVIDED TO BOX HILL WATER REQUIREMENTS.
27. PRESSURE TRANSMITTER TO BE MEASUREX MRB21 GENERAL PURPOSE TRANSMITTER WITH MICROSPIDER LOGGING TELEMETRY AND ALARM PER ALTOGETHER GROUP REQUIREMENTS.
28. WORK-AS-CONSTRUCTED DOCUMENTATION SHALL BE PROVIDED BY THE CONTRACTOR STRICTLY IN ACCORDANCE WITH THE ALTOGETHER GROUP Q.A. SUBMISSION CHECKLIST.

GENERAL NOTES

1. THIS DRAWING SET SHALL BE READ IN CONJUNCTION WITH THE HILLS SHIRE COUNCIL STANDARDS, ALTOGETHER GROUP SUPPLEMENTARY MANUAL TO W.S.A.A. & OTHER ASSOCIATED DRAWINGS AND TECHNICAL SPECIFICATIONS.
2. ALL PRESSURE SEWER LATERALS & RECYCLED WATER PROPERTY SERVICE CONNECTIONS CROSSING CARRIAGEWAYS SHALL BE INSTALLED WITHIN INDIVIDUAL SERVICE CONDUITS.
3. THE CONTRACTOR SHALL LOCATE AND IDENTIFY ALL UNDERGROUND SERVICES PRIOR TO COMMENCEMENT OF WORKS AND SHALL REPAIR ANY DAMAGE CAUSED TO SUCH SERVICES DURING THE COURSE OF WORKS. ANY SERVICE LOCATIONS ON THE FOLLOWING DRAWINGS ARE INDICATIVE ONLY.
4. MAKE SMOOTH TRANSITION TO EXISTING WORKS (i.e. ROAD PAVEMENTS AND FOOTPATHS TO P.C.A. AND SUPERINTENDENTS REQUIREMENTS).
5. SUITABLE PROTECTION OF EXISTING ROAD PAVEMENT, KERB AND GUTTER, FOOTPATHS AND ANY EXISTING FEATURES SHALL BE PROVIDED UNTIL THE CONSTRUCTION WORKS ARE COMPLETED.

CLEARANCES BETWEEN PIPELINES & UNDERGROUND SERVICES

Utility (Existing or proposed service)	Minimum horizontal clearance mm		Minimum vertical clearance <sup>1</sup> mm
	New main size		
	≤DN200	>DN200	
Water mains <sup>2</sup> > DN375	600	600	300
Water mains <sup>2</sup> ≤ DN375	300 <sup>4</sup>	600	150
Gas mains	300 <sup>4</sup>	600	150
Telecommunication conduits and cables	300 <sup>4</sup>	600	150
Electricity conduits and cables	500	1000	225 <sup>4</sup>
Stormwater drains	300 <sup>4</sup>	600	150 <sup>5</sup>
Sewers - gravity	1000 <sup>4</sup> / 600	1000 <sup>4</sup> / 600	500 <sup>4</sup>
Sewers - pressure and vacuum	600	600	300 <sup>4</sup>
Kerbs	150	600 <sup>4</sup>	150 (where possible)

- NOTES:
1. Vertical clearances apply where pipelines cross other utility services, except in the case of water/sewer mains when a vertical separation shall always be maintained, even when the pressure sewer and water main are parallel. The pressure sewer should always be located below the water main to minimise the possibility of backflow contamination in the event of a pressure main break.
2. Water mains includes mains supplying both potable and recycled water.
3. For areas with existing water reticulation, clearances can be further reduced to 600mm with the approval of the water authority.
4. Clearances can be further reduced to 150mm for distances up to 2m when passing installations such as poles, pits, and small structures, providing the structures is not destabilised in the process.
5. Clearances from kerbs shall be measured from the nearest point of the kerb. For water/sewer <DN375, clearances from kerbs can be progressively reduced until the minimum of 150mm is reached for water/sewer <DN200.
6. Where a parallel sewer is at minimum vertical clearance (lower than the water main (500mm), maintain a minimum horizontal of 1000mm. this minimum clearance can be progressively reduced to 600mm as the vertical clearance is increased to 750mm.
7. For pressure sewer laterals, minimum vertical clearances may be reduced to 150mm providing there is no joint in the lateral within 500mm of either side of the service being crossed.
8. An additional clearance from high voltage electrical installations should be maintained above the conduits or cables to allow for a protective barrier and marking to be provided.
9. Water mains should always cross over sewers and stormwater drains. For cases where this is no alternative and the main must cross under the sewer, the design shall nominate an appropriate protection treatment (joint-free in the vicinity of the sewer).

\* SHOULD THE RECOMMENDED CLEARANCES NOT BE ACHIEVED, NOTIFICATION SHALL BE CONVEYED TO THE BOX HILL WATER REPRESENTATIVE IN WRITING.

PRESSURE SEWER PIPE SCHEDULE

SIZE	TYPE	CLASS	LENGTH
DN125	PE100	PN16	36.6
DN90	PE100	PN16	66.8
DN63	PE100	PN16	155.1
DN50	PE100	PN16	296.7
DN40	PE100	PN16	835.5
TOTAL			1,390.7


RECYCLED WATER PIPE SCHEDULE

SIZE	TYPE	CLASS	LENGTH
DN150	m.P.V.C.	PN16	142.7
DN100	m.P.V.C.	PN16	401.8
TOTAL			544.5

ALTOGETHER GROUP STANDARD DRAWINGS CAN BE FOUND AT THE FOLLOWING ADDRESS:


<https://askus.altogethergroup.com.au/hc/en-us/articles/900004827263-Standard-drawings-for-land-developers->

ROSE ATKINS RIMMER (Infrastructure) Pty. Ltd.



WATER RELATED INFRASTRUCTURE DESIGN AND MANAGEMENT

SHOP 7 & 8 'M CENTRE'  
40 STERLING ROAD, MINCHINBURY NSW 2770  
PH: (02) 9853 0200 FAX: (02) 9671 7399



GENERAL NOTES			
DRAWN:	D.SHEATHER	DESIGNED:	D.SHEATHER
REVIEWED:	K.GAO	VERIFIED:	K.GAO
SCALE:	-	DATA:	-
U.S.A. REFERENCE:	88 H15	DATE OF ISSUE:	1/4/2022

SHEET 2 OF 7


VERSION: WAC

JOB No: 4/23645/B3D




Precinct B Development Stages


- Stage 1
- Stage 2
- Stage 3
- Stage 4

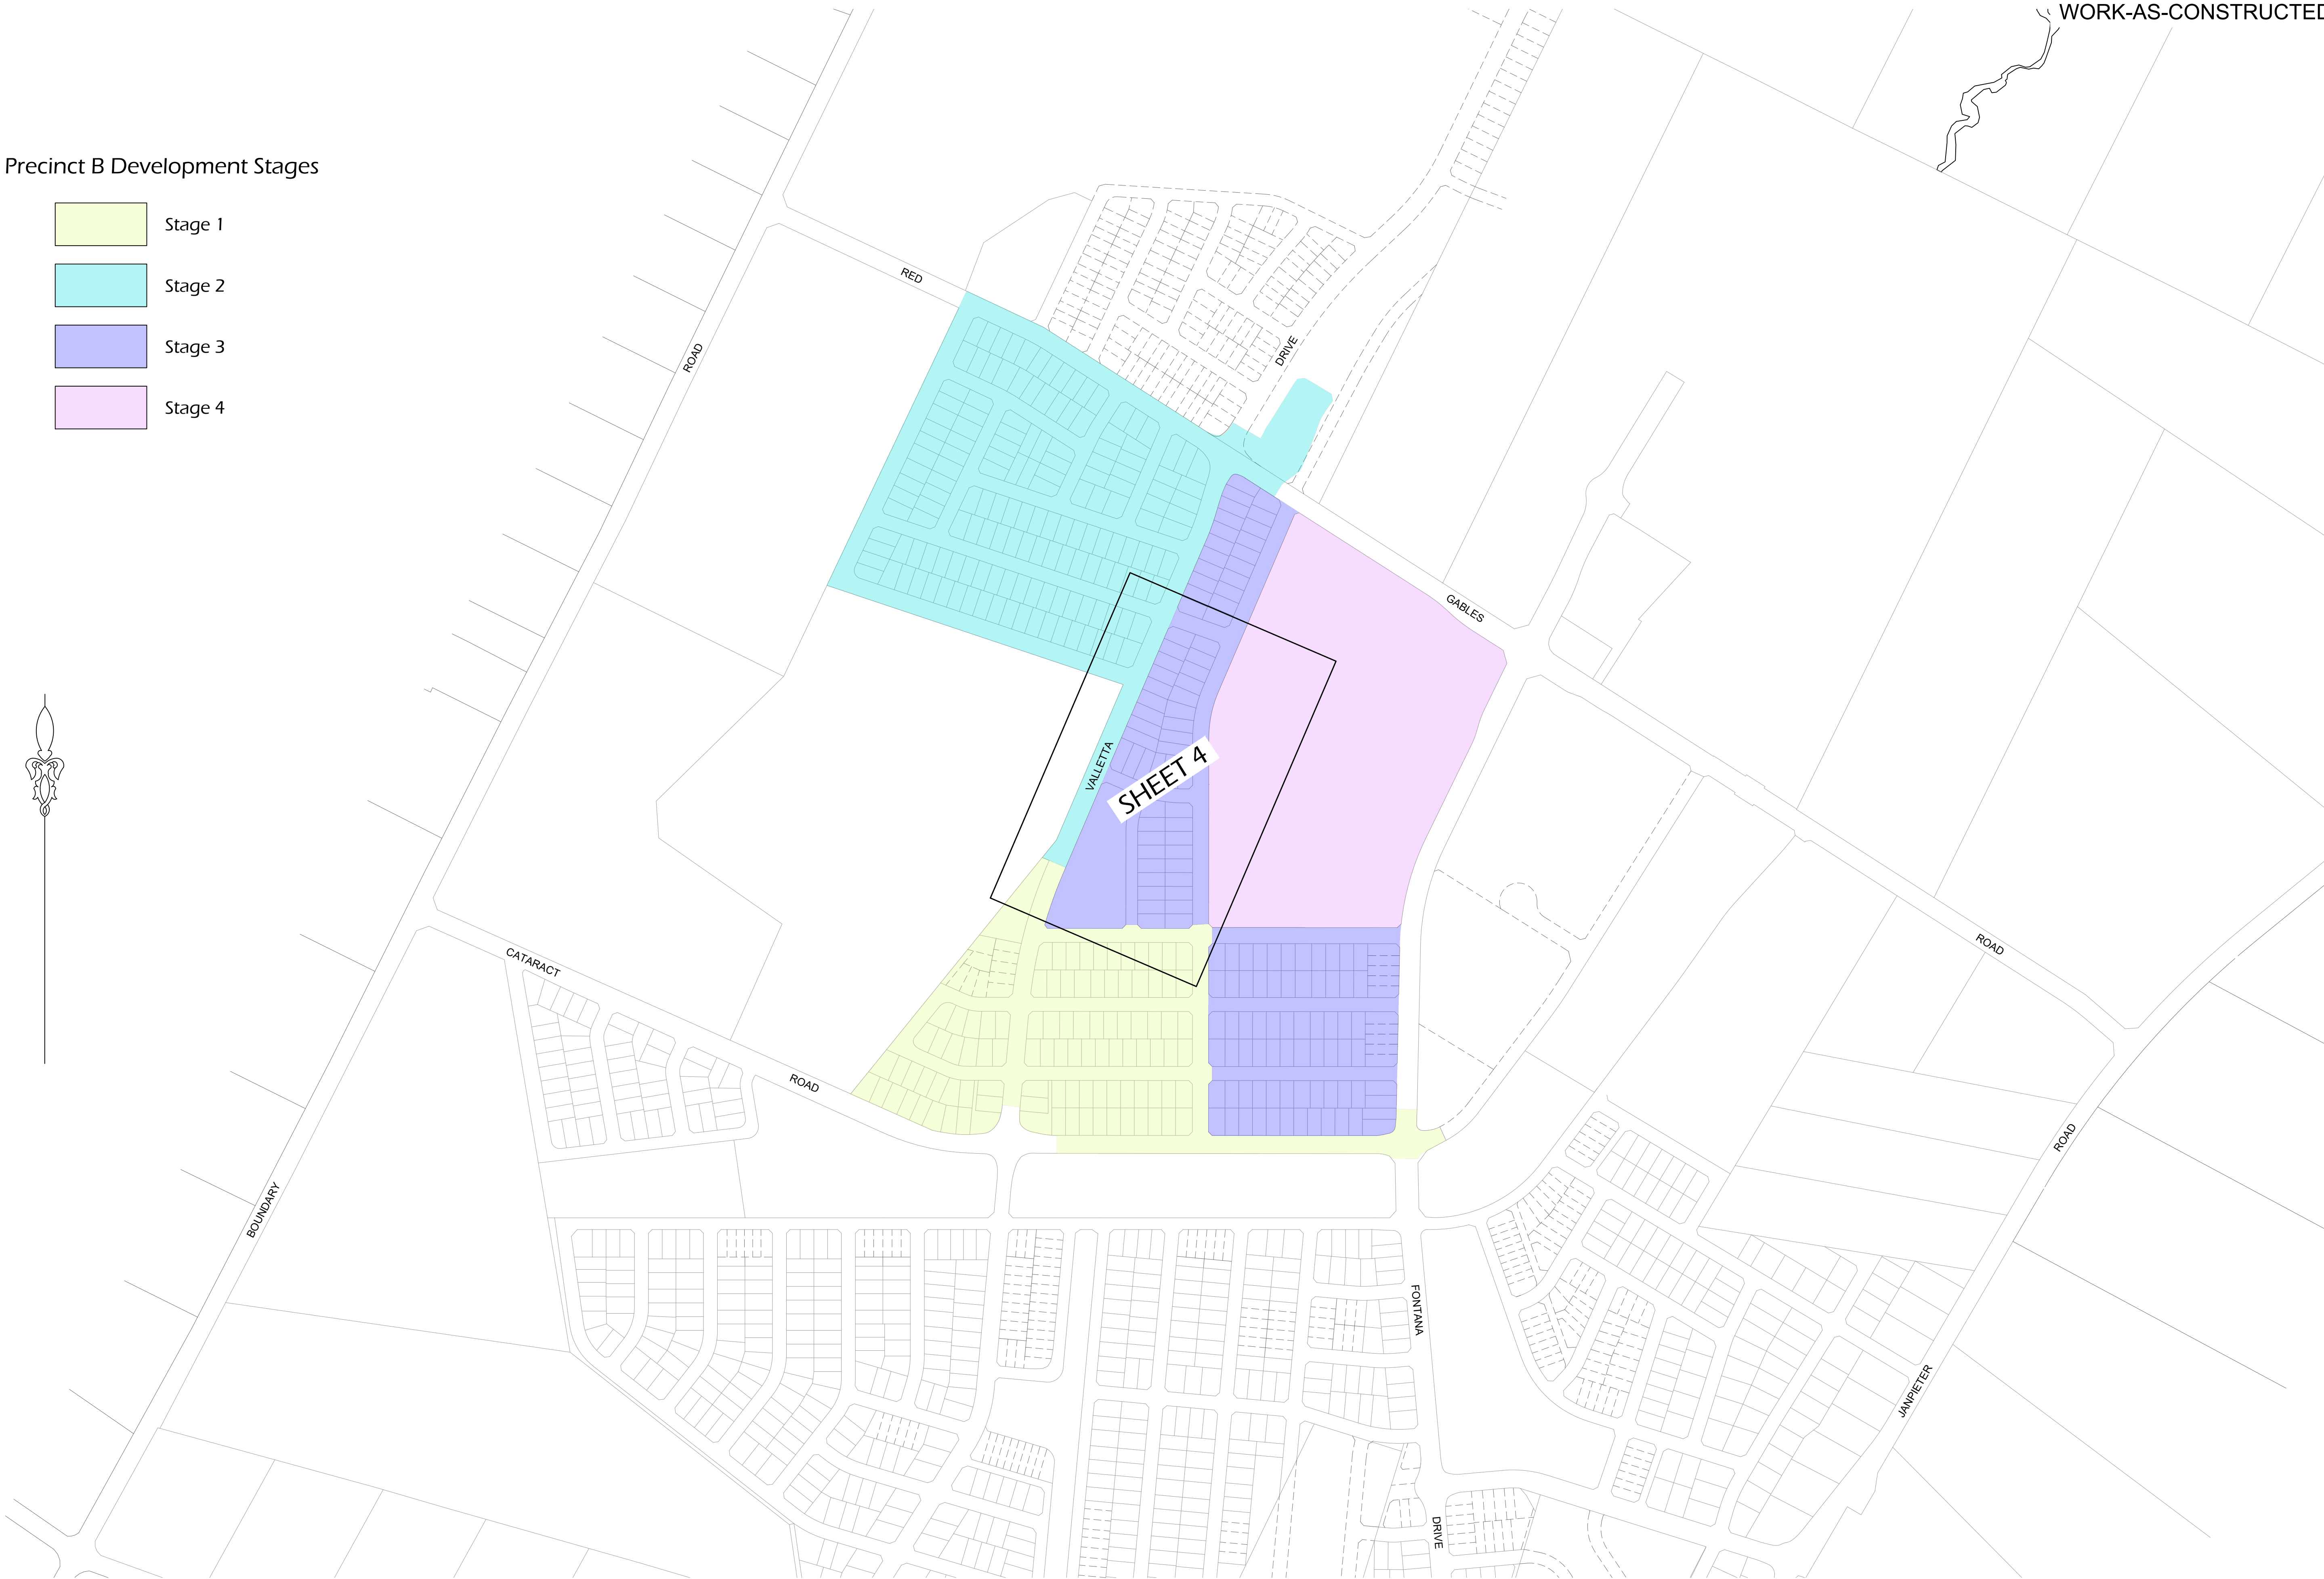



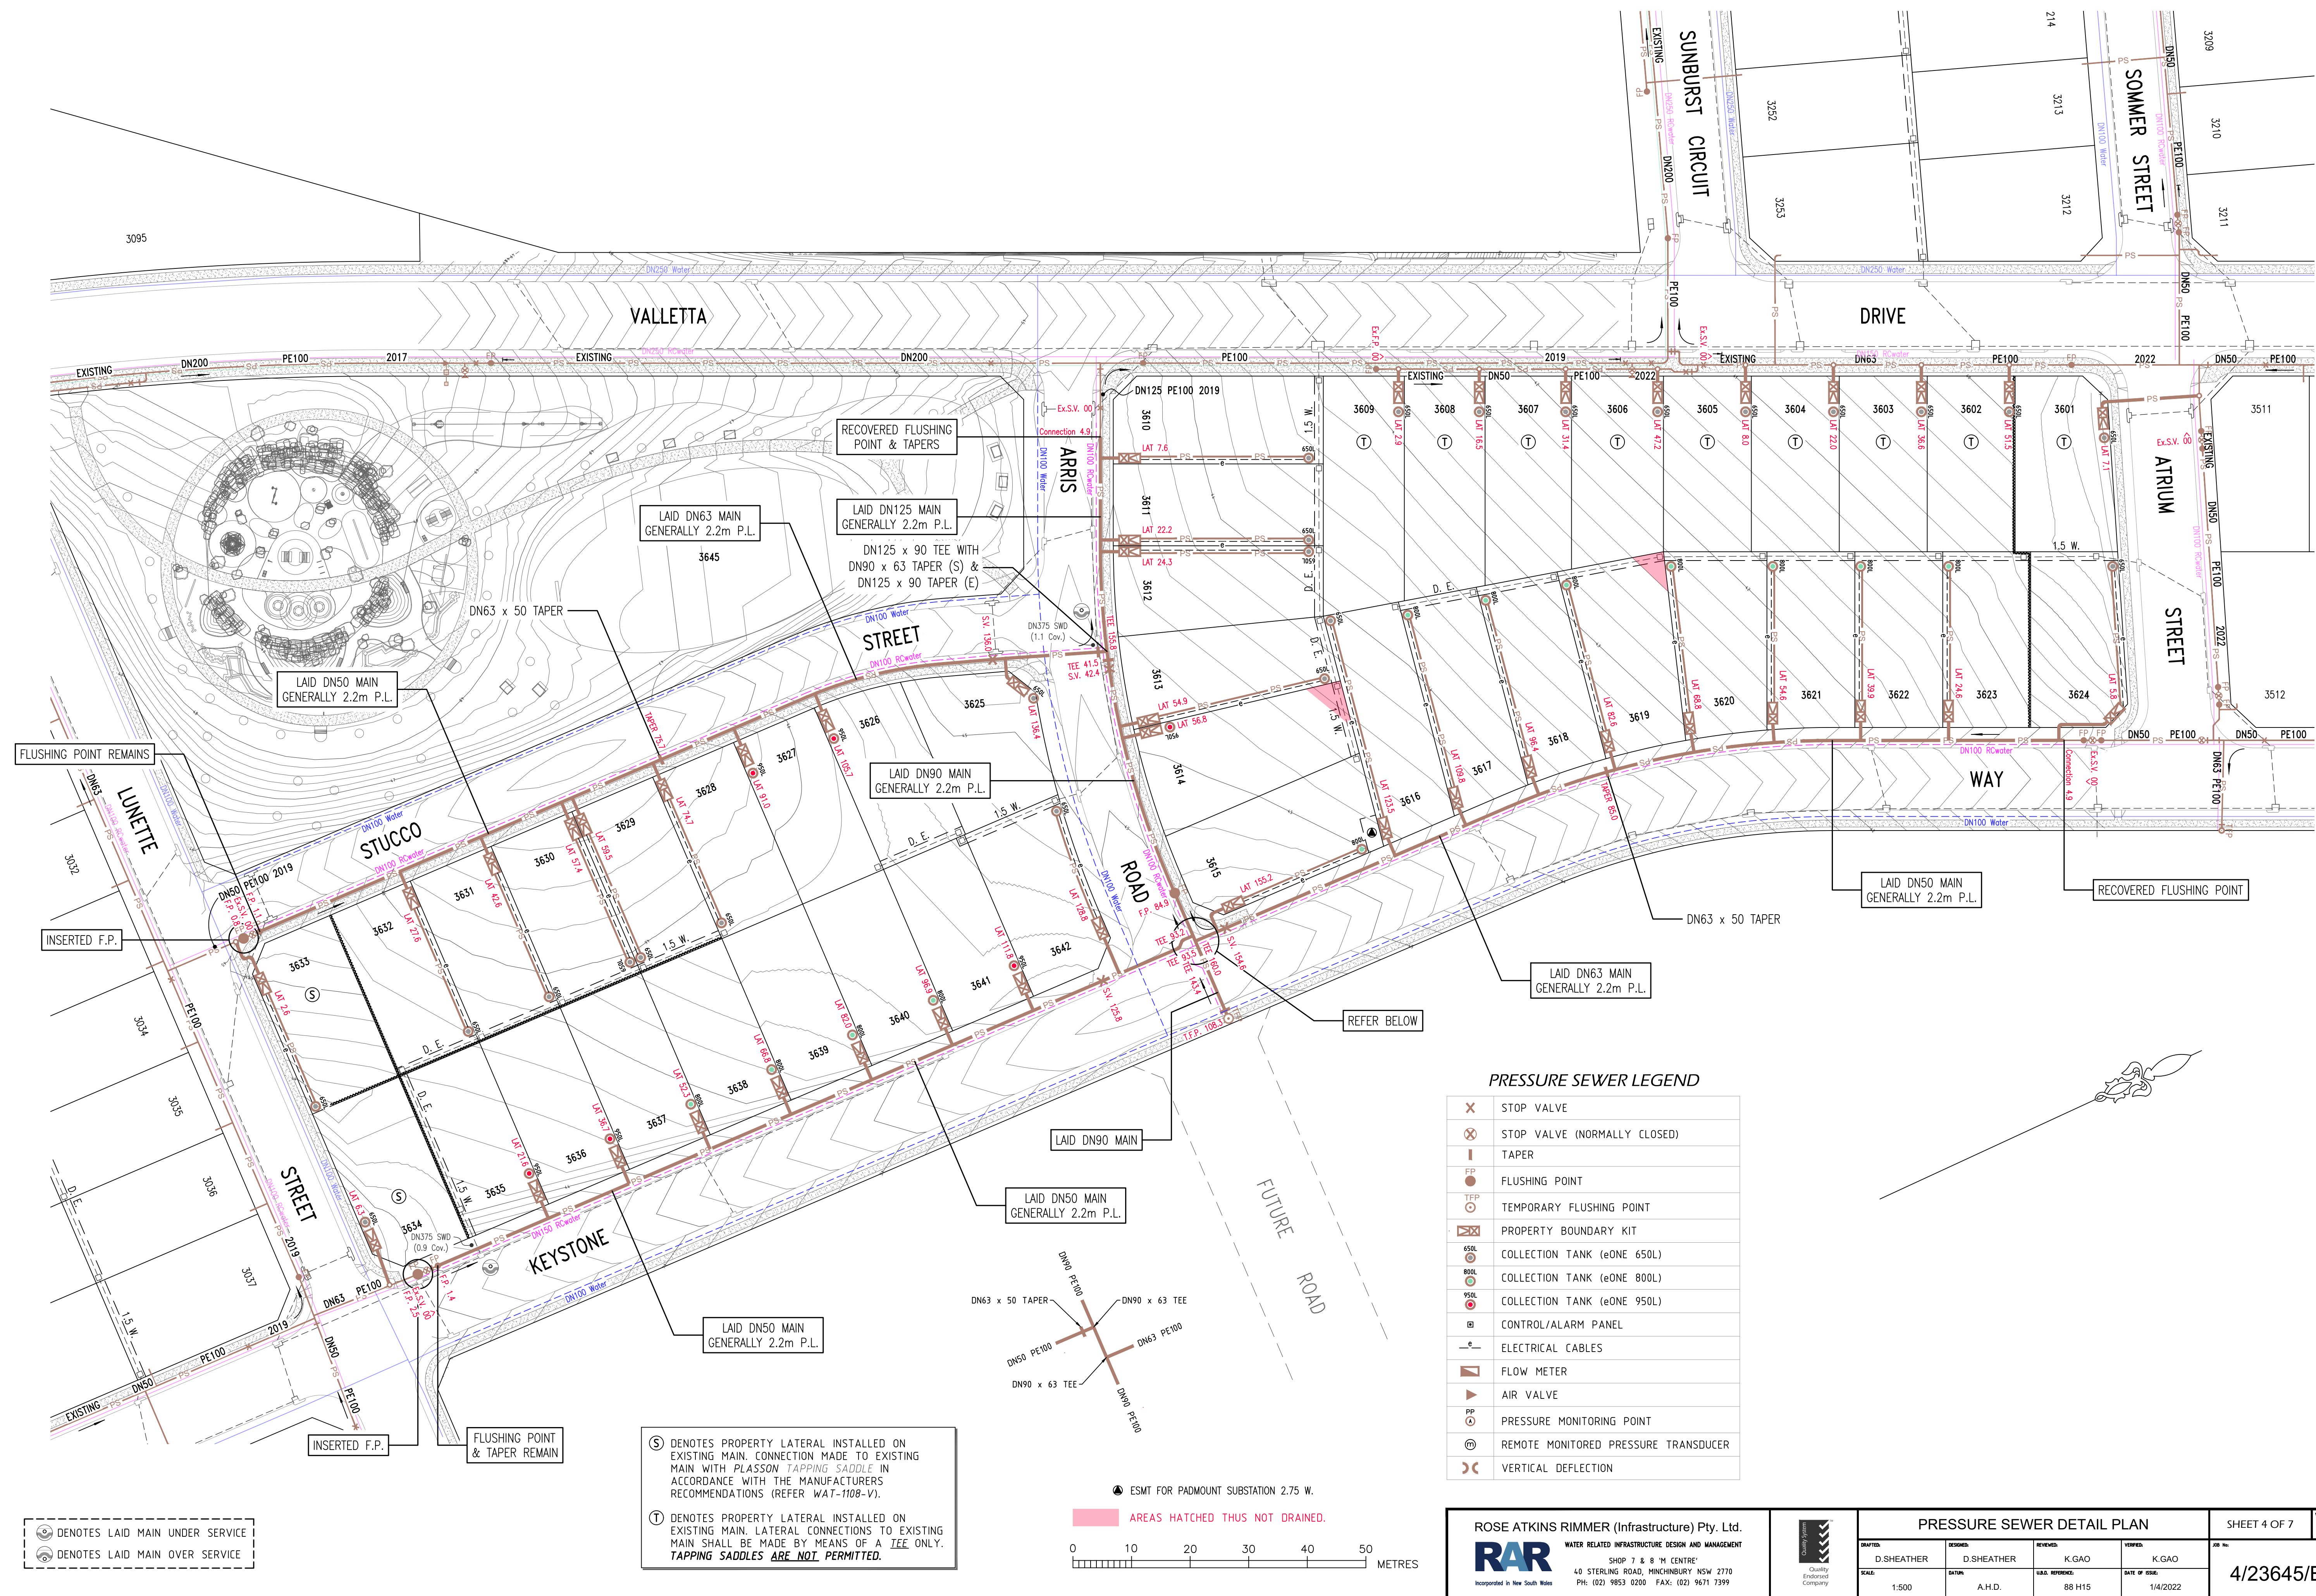




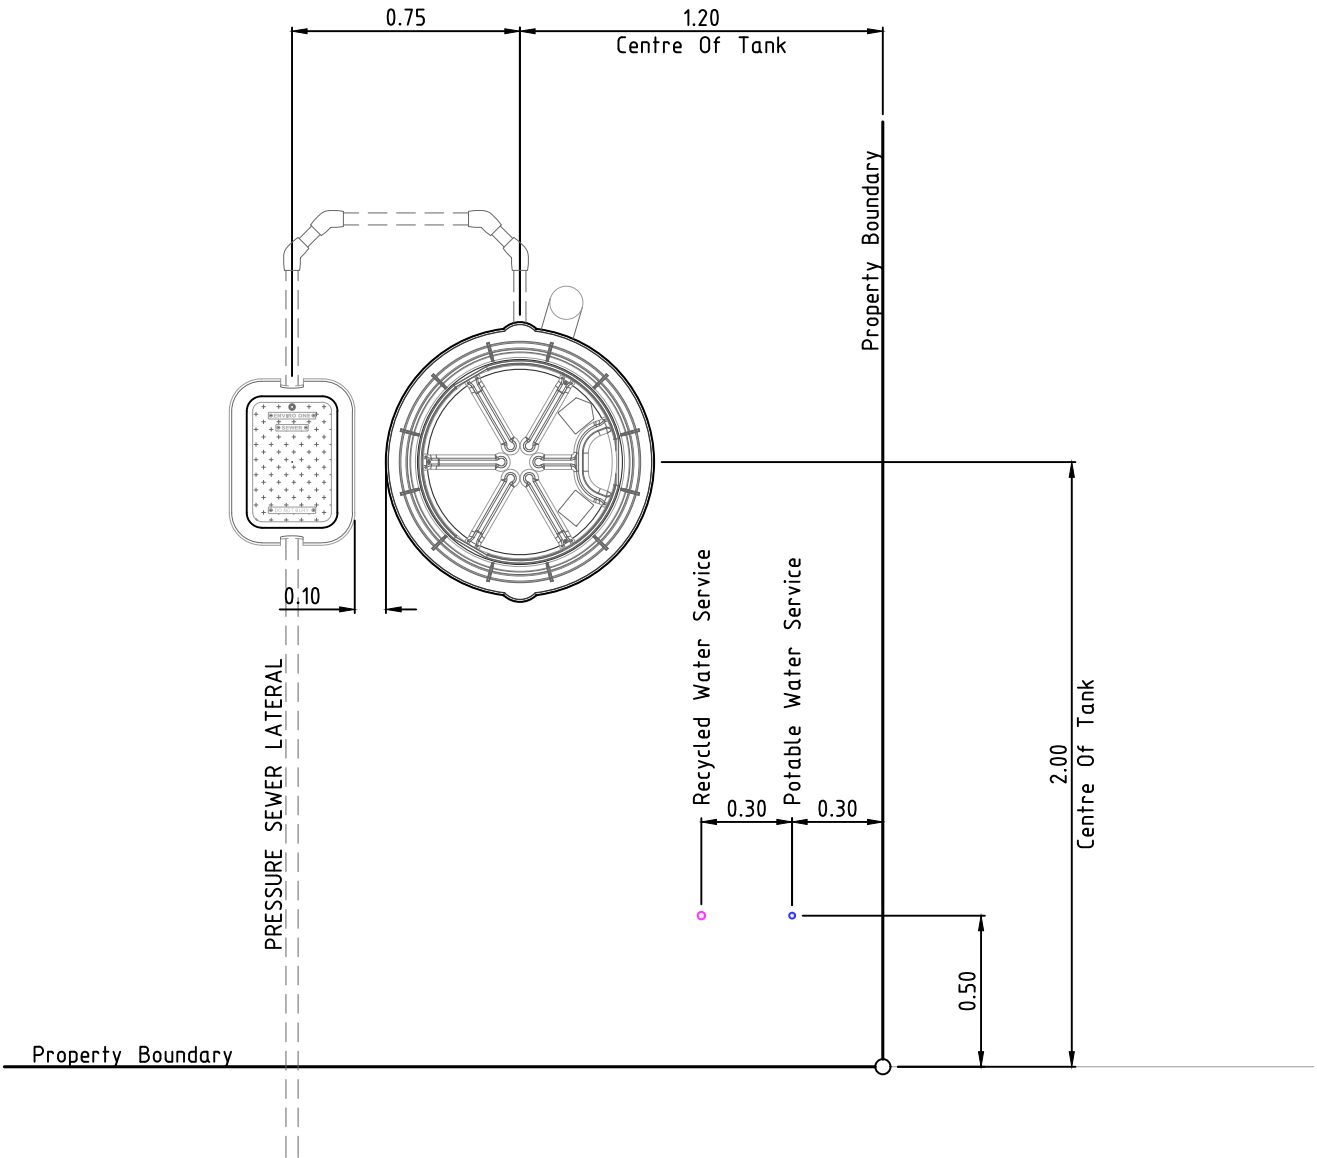

TYPICAL INFRASTRUCTURE SETOUT DIMENSIONS

SCALE 1:25

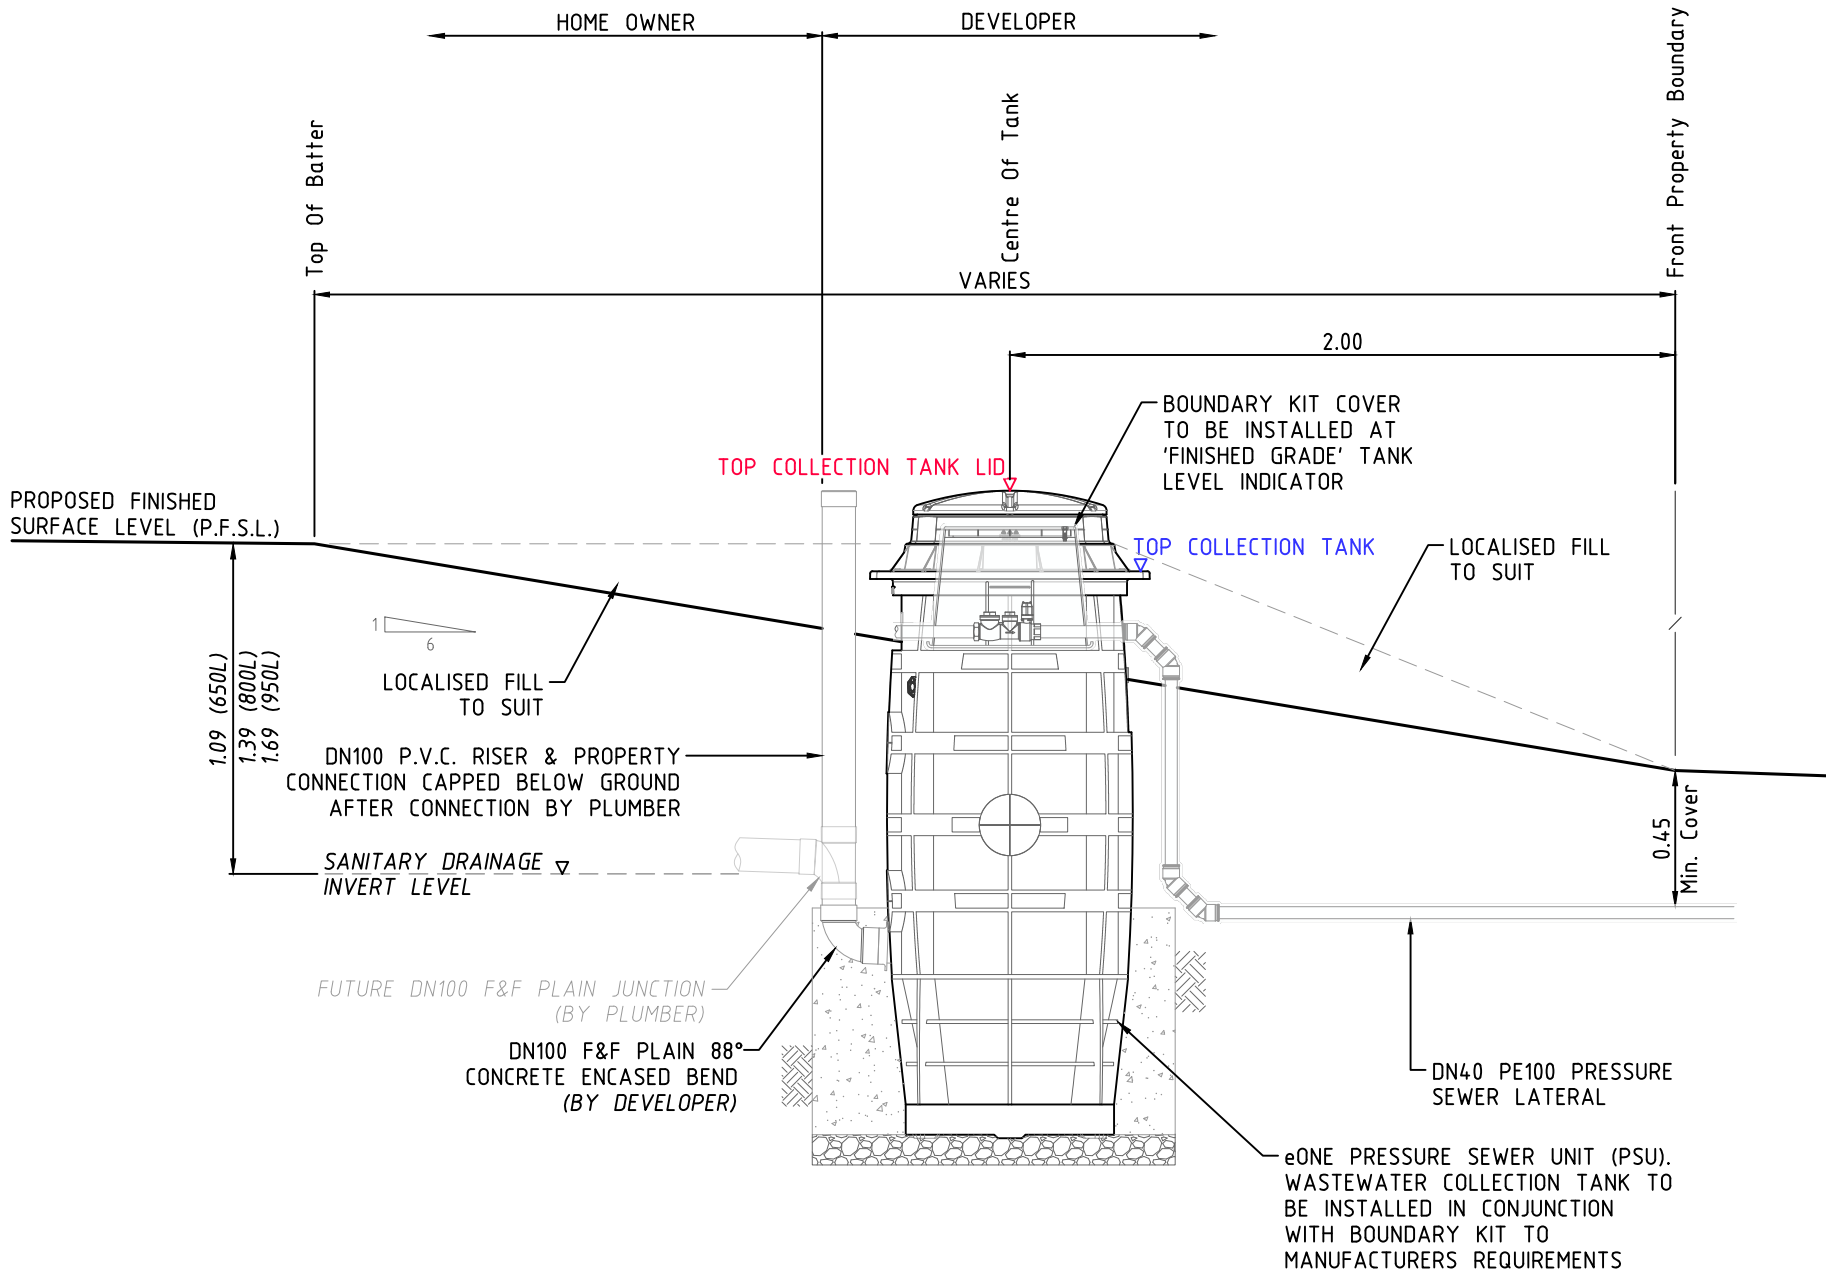

COLLECTION TANK SECTIONAL ELEVATION

SCALE 1:25

COLLECTION TANK NOTES

- DESIGN SURFACE LEVELS WERE ELECTRONICALLY EXTRACTED FROM DIGITAL DATA SUPPLIED BY ENSPIRE DATED 11/12/20 (201211\_PRECINCT B3D 3D SURFACE.dwg).
- DESIGN LEVELS CAN ONLY BE ASSUMED AS CURRENT AT TIME OF EXTRACTION. ALL LEVELS SHALL BE CONFIRMED WITH THE SITE SUPERINTENDENT *PRIOR* TO INSTALLATION OF TANKS. SHOULD THE PROPOSED FINISHED SURFACE LEVEL (P.F.S.L.) DIFFER FROM DESIGN BY MORE THAN 100mm, THE CONSTRUCTOR SHALL CONTACT THE DESIGNER IMMEDIATELY.
- COLLECTION TANK SETOUT SHALL BE COMPLIANT WITH [FSI-1000-FS](#) & [FSI-SK03A-FS](#). COLLECTION TANK INSTALLATION LEVELS DOCUMENTED ADJACENT SHALL SUPERSEDE ANY LEVELS ADVISED ON DRAWING FSI-SK03A-FS.
- R.A.R. ACCEPT NO RESPONSIBILITY FOR INCONSISTENCIES IN EXTRACTED LEVELS RESULTING FROM CHANGES TO THE MODEL (SURFACE LEVEL) INFORMATION POST DATA EXTRACTION DATE.


PRESSURE SEWER COLLECTION TANK LEVEL DETAILS								
THE GABLES DEVELOPMENT - PRECINCT B [STAGE 3D]								
LOT NUMBER	COLLECTION TANK LOCATION	TANK SIZE	PFSL AT TANK LOCATION	TOP OF COLLECTION TANK	DESIGN SANITARY DRAINAGE INVERT LEVEL	TOP OF COLLECTION TANK LID *	CALCULATED SANITARY DRAINAGE INVERT LEVEL	WAC v's DESIGN INVERT LEVEL COMPARISON
	[FRONT / REAR]	[650L / 800L / 950L]		[Design R.L.]	[Design R.L.]	[Work-As-Constructed]	[Work-As-Constructed]	[- LOWER / + HIGHER]
3601	FRONT BATTER	650L	38.99	39.11	38.11	39.43	38.16	0.05
3602	FRONT FLAT	650L	39.88	39.84	38.84	40.10	38.83	-0.01
3603	FRONT FLAT	650L	40.25	40.21	39.21	40.50	39.23	0.02
3604	FRONT FLAT	650L	40.63	40.59	39.59	40.88	39.61	0.02
3605	FRONT FLAT	650L	41.01	40.97	39.97	41.22	39.95	-0.02
3606	FRONT FLAT	650L	41.42	41.38	40.38	41.53	40.26	-0.12
3607	FRONT FLAT	650L	41.88	41.84	40.84	42.05	40.78	-0.06
3608	FRONT FLAT	650L	42.33	42.29	41.29	42.60	41.33	0.04
3609	FRONT FLAT	650L	42.77	42.73	41.73	43.04	41.77	0.04
3610	REAR	650L	43.46	43.42	42.42	43.74	42.47	0.05
3611	REAR	650L	43.80	43.76	42.76	44.01	42.74	-0.02
3612	REAR	650L	43.85	43.81	42.81	44.09	42.82	0.01
3613	REAR	650L	44.33	44.29	43.29	44.59	43.32	0.03
3614	FRONT FLAT	950L	44.96	44.92	43.32	45.19	43.32	0.00
3615	REAR	800L	45.01	44.97	43.67	45.23	43.66	-0.01
3616	REAR	650L	44.07	44.03	43.03	44.30	43.03	0.00
3617	REAR	800L	43.78	43.74	42.44	43.98	42.41	-0.03
3618	REAR	800L	43.32	43.28	41.98	43.52	41.95	-0.03
3619	REAR	800L	42.86	42.82	41.52	43.07	41.50	-0.02
3620	REAR	800L	42.26	42.22	40.92	42.44	40.87	-0.05
3621	REAR	800L	41.77	41.73	40.43	42.02	40.45	0.02
3622	REAR	800L	41.35	41.31	40.01	41.60	40.03	0.02
3623	REAR	800L	40.95	40.91	39.61	41.16	39.59	-0.02
3624	REAR	650L	39.25	39.21	38.21	39.54	38.27	0.06
3625	FRONT FLAT	650L	44.68	44.64	43.64	44.92	43.65	0.01
3626	FRONT FLAT	950L	45.76	45.72	44.12	45.99	44.12	0.00
3627	FRONT FLAT	950L	46.27	46.23	44.63	46.54	44.67	0.04
3628	REAR	650L	45.85	45.81	44.81	46.09	44.82	0.01
3629	REAR	650L	45.95	45.91	44.91	46.14	44.87	-0.04
3630	REAR	650L	45.95	45.91	44.91	46.15	44.88	-0.03
3631	REAR	650L	45.88	45.84	44.84	46.10	44.83	-0.01
3632	REAR	650L	45.61	45.57	44.57	45.80	44.53	-0.04
3633	REAR	650L	43.77	43.73	42.73	44.02	42.75	0.02
3634	FRONT BATTER	650L	42.53	42.73	41.73	42.99	41.72	-0.01
3635	FRONT BATTER	950L	43.96	44.16	42.56	44.35	42.48	-0.08
3636	FRONT BATTER	950L	44.33	44.41	42.81	44.65	42.78	-0.03
3637	FRONT BATTER	800L	44.70	44.71	43.41	44.98	43.41	0.00
3638	FRONT BATTER	800L	45.07	45.01	43.71	45.31	43.74	0.03
3639	FRONT FLAT	800L	45.39	45.35	44.05	45.68	44.11	0.06
3640	FRONT FLAT	800L	45.67	45.63	44.33	45.94	44.37	0.04
3641	FRONT FLAT	950L	45.82	45.78	44.18	46.05	44.18	0.00
3642	REAR	650L	45.08	45.04	44.04	45.12	43.85	-0.19

\* COLLECTION TANK LEVEL PROVIDED TO G.P.S. ACCURACY ONLY. THE BUILDER IS REQUIRED TO CONFIRM DRAINAGE CONSTRAINTS PRIOR TO MAKING CONNECTION TO TANK.




Precinct B Development Stages

- Stage 1
- Stage 2
- Stage 3
- Stage 4

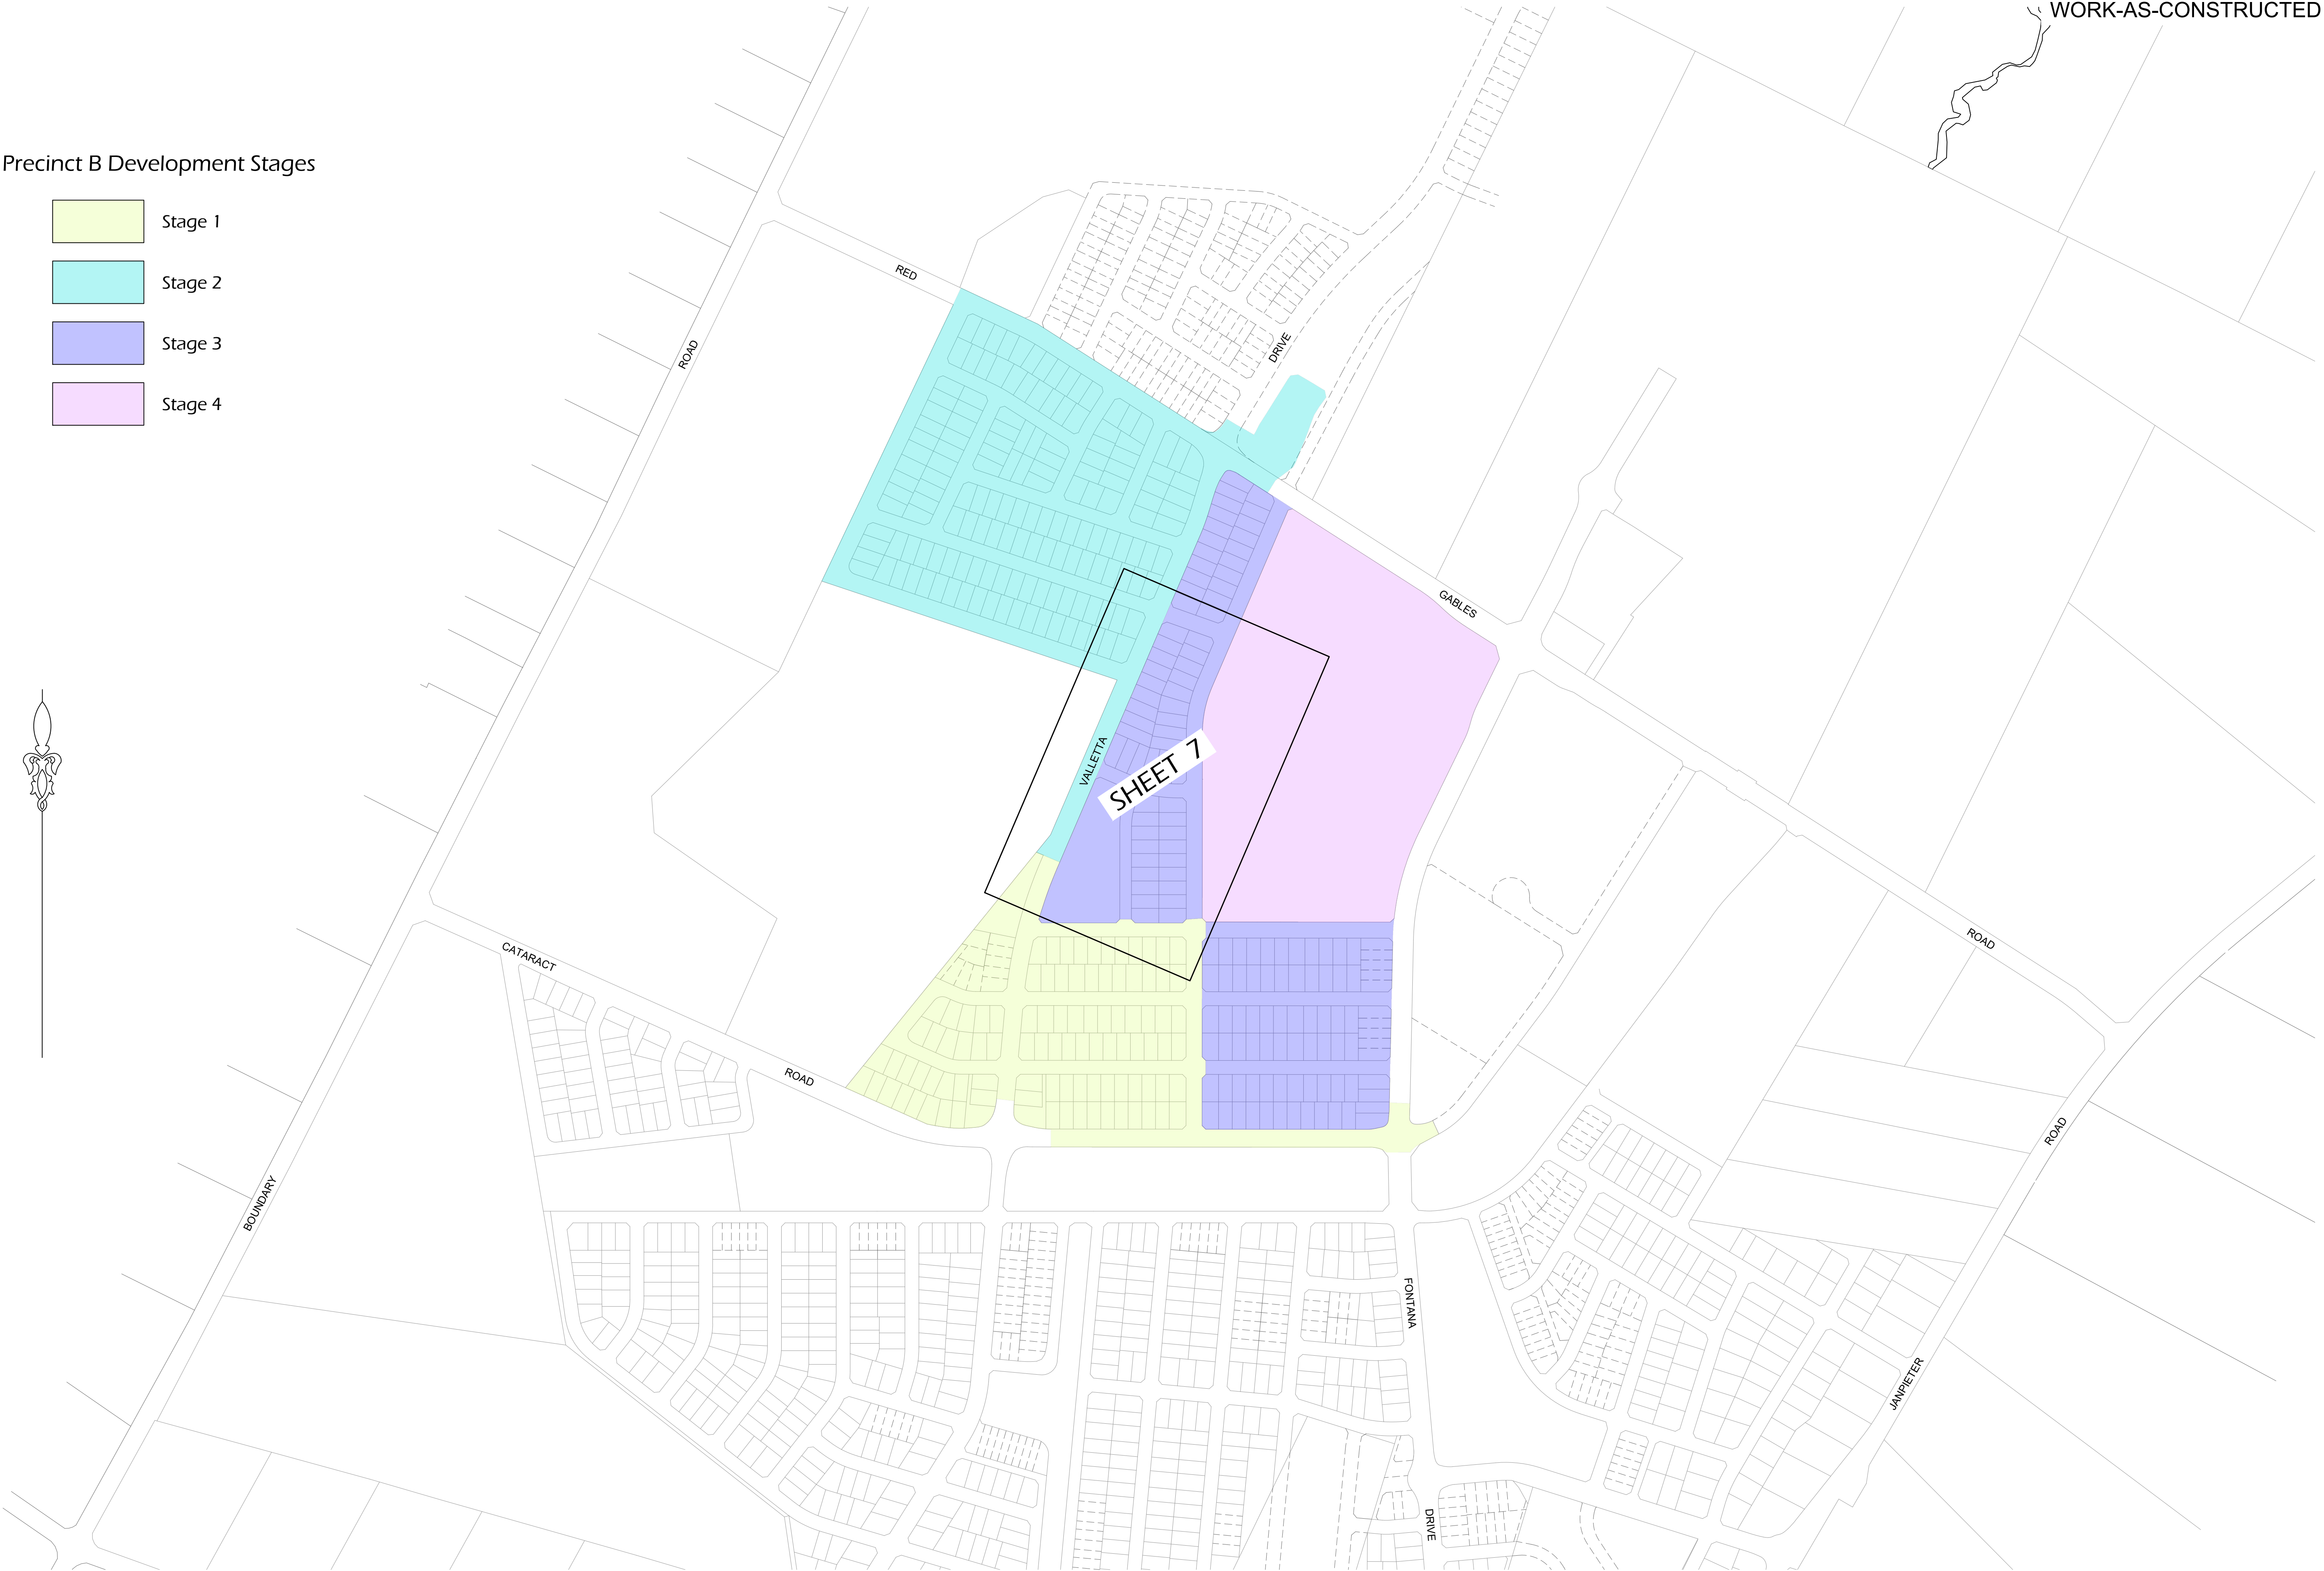




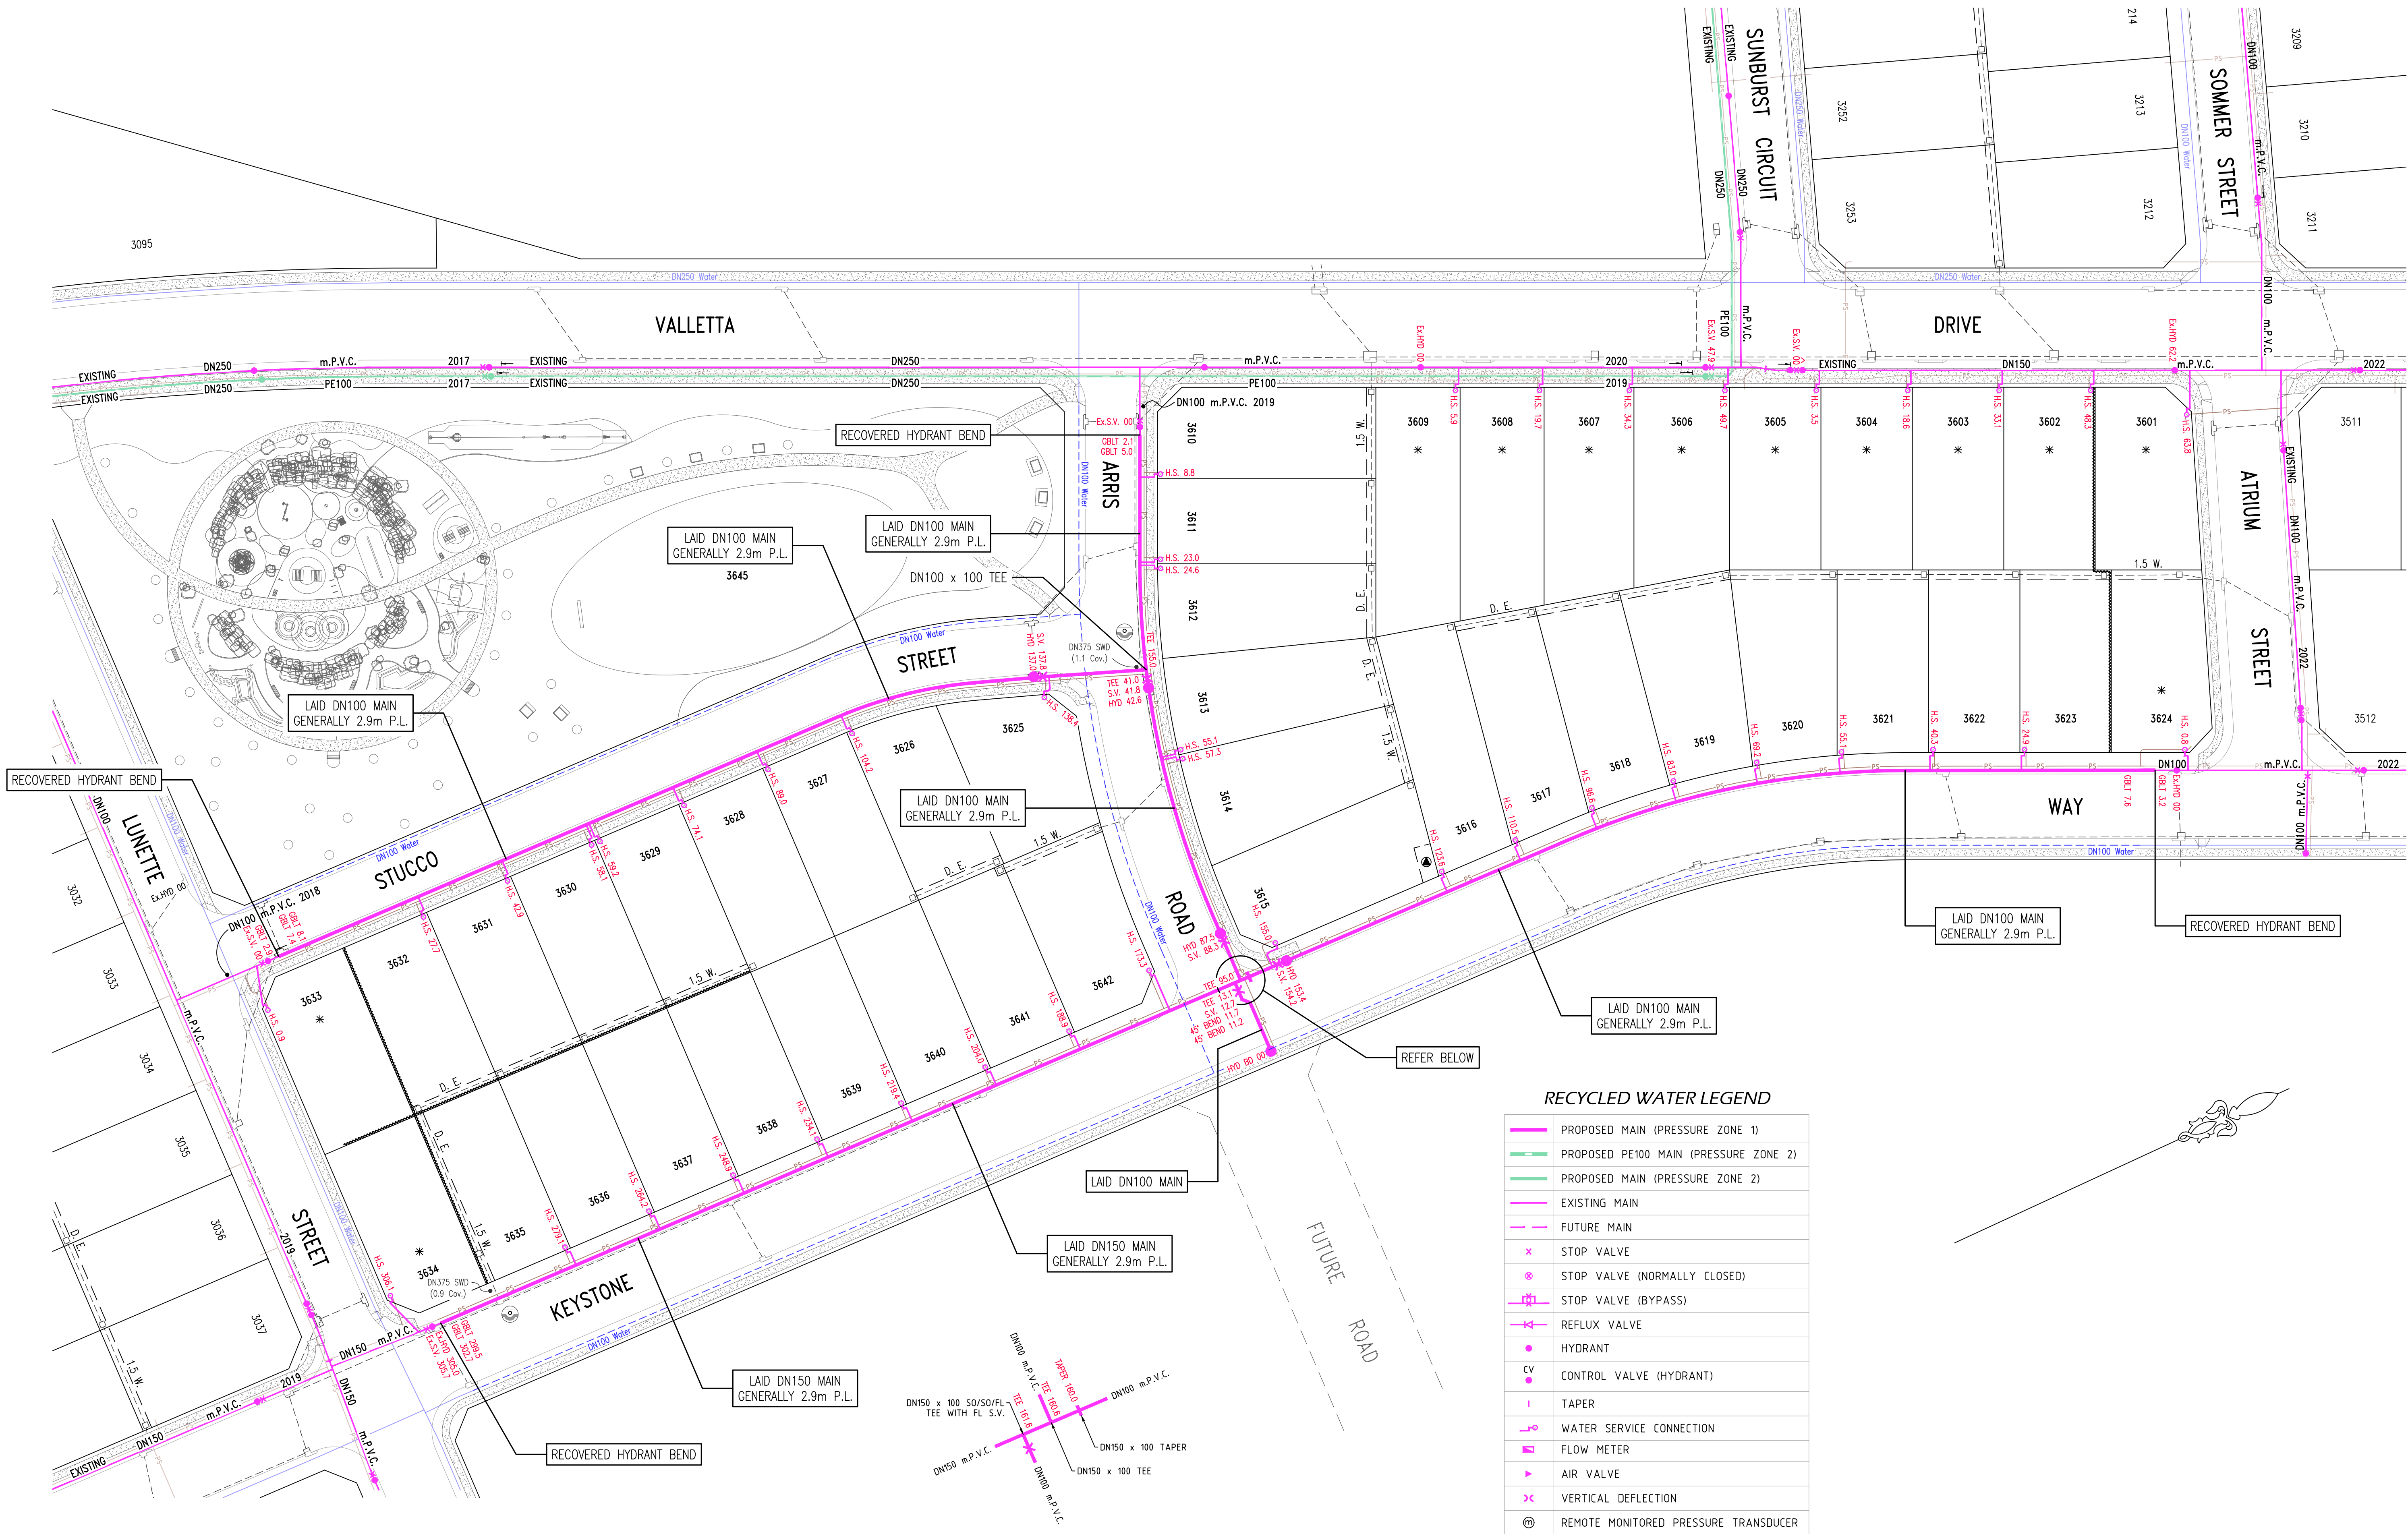

RECYCLED WATER LEGEND	
	PROPOSED MAIN (PRESSURE ZONE 1)
	PROPOSED PE100 MAIN (PRESSURE ZONE 2)
	PROPOSED MAIN (PRESSURE ZONE 2)
	EXISTING MAIN
	FUTURE MAIN
	STOP VALVE
	STOP VALVE (NORMALLY CLOSED)
	STOP VALVE (BYPASS)
	REFLUX VALVE
	HYDRANT
	CONTROL VALVE (HYDRANT)
	TAPER
	WATER SERVICE CONNECTION
	FLOW METER
	AIR VALVE
	VERTICAL DEFLECTION
	REMOTE MONITORED PRESSURE TRANSDUCER

⊙ DENOTES LAID MAIN UNDER SERVICE  
⊙ DENOTES LAID MAIN OVER SERVICE

\* DENOTES WATER SERVICE INSTALLED ON EXISTING MAIN  
⊙ ESMT FOR PADMOUNT SUBSTATION 2.75 W.

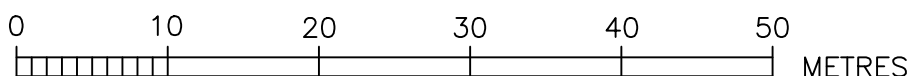

ROSE ATKINS RIMMER (Infrastructure) Pty. Ltd.  
**RAR**  
WATER RELATED INFRASTRUCTURE DESIGN AND MANAGEMENT  
SHOP 7 & 8 'M CENTRE'  
40 STERLING ROAD, MINCHINBURY NSW 2770  
PH: (02) 9853 0200 FAX: (02) 9671 7399



RECYCLED WATER DETAIL PLAN			
DESIGNED D.SHEATHER	DESIGNED D.SHEATHER	REVIEWED K.GAO	VERIFIED K.GAO
SCALE 1:500	DATE -	DATA REFERENCE 88 H15	DATE OF ISSUE 1/4/2022