

THE GABLES

BOX HILL

PRECINCT H

STAGE 2

PRESSURE SEWER & RECYCLED WATER



LOCALITY PLAN
(NOT TO SCALE)

DRAWING LIST	
SHEET 1	COVER SHEET
SHEET 2	GENERAL NOTES
SHEET 3	PRESSURE SEWER GENERAL ARRANGEMENT
SHEET 4	PRESSURE SEWER DETAIL PLAN 1
SHEET 5	PRESSURE SEWER DETAIL PLAN 2
SHEET 6	PRESSURE SEWER DETAIL PLAN 3
SHEET 7	PRESSURE SEWER DETAIL PLAN 4
SHEET 8	COLLECTION TANK SETOUT DETAILS
SHEET 9	COLLECTION TANK LEVEL DETAILS 1
SHEET 10	COLLECTION TANK LEVEL DETAILS 2
SHEET 11	RECYCLED WATER GENERAL ARRANGEMENT
SHEET 12	RECYCLED WATER DETAIL PLAN 1
SHEET 13	RECYCLED WATER DETAIL PLAN 2
SHEET 14	RECYCLED WATER DETAIL PLAN 3
SHEET 15	RECYCLED WATER DETAIL PLAN 4

09	WORK-AS-CONSTRUCTED	D.S.	5/2/18
08a	SUPER LOTS RENUMBERED	K.G.	11/9/17
08	2200L TANK UPDATE	D.S.	5/6/17
07	SERVICE CROSSINGS MODIFIED (CLIENT REQUEST)	G.R.	28/4/17
06	DN140 PE100 RW MAIN UPSIZED	K.G.	16/3/17
05	ISSUE FOR FLOW SYSTEMS APPROVAL	K.G.	6/3/17
04	SUPERLOTS UPDATED	K.G.	16/2/17
03	ISSUE FOR TENDER	K.G.	9/12/16
02	MAIN SIZING UPDATED & CC PLAN UPDATED	K.G.	11/11/16
01	ORIGINAL ISSUE	D.S.	
No.	REVISION DESCRIPTION	BY	DATE

SERVICE	DATE	REF.	WORK-AS-CONSTRUCTED CERTIFICATION		 ROSE ATKINS RIMMER (Infrastructure) Pty. Ltd. WATER RELATED INFRASTRUCTURE DESIGN AND MANAGEMENT 142 SUNNYHOLT ROAD, BLACKTOWN P.O. BOX 6745, BLACKTOWN N.S.W. 2148 PH: (02) 9853 0200 FAX: (02) 9671 7399 Incorporated in New South Wales	CLIENT	 Box Hill Water CELESTINO	TITLE	COVER SHEET					SHEET 1 OF 15	VERSION
			DEVELOPER:	CELESTINO DEVELOPMENTS Pty. Ltd.					PLAN OF PROPOSED WATER INFRASTRUCTURE SERVICES					4/23645/H2	WAC
			PROJECT SUPERVISOR:	ROSE ATKINS RIMMER (INFRASTRUCTURE) Pty. Ltd.					THE GABLES DEVELOPMENT - PRECINCT H (STAGE 2)						
			CONSTRUCTOR:	C. J. DOYLE CONTRACTING SERVICES Pty. Ltd.					BOUNDARY ROAD, BOX HILL NORTH						
			COMPLETED:	W.A.C. PREPARED: 5/2/2018					L.G.A. THE HILLS						
					 Quality Endorsed Company			DESIGNED:	K.GAO	REVIEWED:	V.VIKSNE	VERIFIED:	D.SHEATHER	JOB No.	
								DRAWN:	K.GAO	DATE:	108 L2-L3	DATE OF ISSUE:	5/2/2018		

GENERAL NOTES

- 1. THIS DRAWING SET SHALL BE READ IN CONJUNCTION WITH THE HILLS SHIRE COUNCIL STANDARDS, FLOW SYSTEMS SUPPLEMENTARY MANUAL TO W.S.A.A. & OTHER ASSOCIATED DRAWINGS AND TECHNICAL SPECIFICATIONS.
- 2. ALL PRESSURE SEWER LATERALS & RECYCLED WATER PROPERTY SERVICE CONNECTIONS CROSSING CARRIAGEWAYS SHALL BE INSTALLED WITHIN INDIVIDUAL SERVICE CONDUITS.
- 3. THE CONTRACTOR SHALL LOCATE AND IDENTIFY ALL UNDERGROUND SERVICES PRIOR TO COMMENCEMENT OF WORKS AND SHALL REPAIR ANY DAMAGE CAUSED TO SUCH SERVICES DURING THE COURSE OF WORKS. ANY SERVICE LOCATIONS ON THE FOLLOWING DRAWINGS ARE INDICATIVE ONLY.
- 4. MAKE SMOOTH TRANSITION TO EXISTING WORKS (i.e. ROAD PAVEMENTS AND FOOTPATHS TO P.C.A. AND SUPERINTENDENTS REQUIREMENTS.
- 5. SUITABLE PROTECTION OF EXISTING ROAD PAVEMENT, KERB AND GUTTER, FOOTPATHS AND ANY EXISTING FEATURES SHALL BE PROVIDED UNTIL THE CONSTRUCTION WORKS ARE COMPLETED.

CLEARANCES BETWEEN PIPELINES & UNDERGROUND SERVICES

Utility (Existing or proposed service)	Minimum horizontal clearance mm		Minimum vertical clearance ¹ mm
	New main size		
	≤DN200	>DN200	
Water mains ² > DN375	600	600	300
Water mains ² ≤ DN375	300 ⁴	600	150
Gas mains	300 ⁴	600	150
Telecommunication conduits and cables	300 ⁴	600	150
Electricity conduits and cables	500	1000	225 ⁴
Stormwater drains	300 ⁴	600	150 ⁴
Sewers - gravity	1000 ⁴ / 600	1000 ⁴ / 600	500 ⁴
Sewers - pressure and vacuum	600	600	300 ⁴
Kerbs	150	600 ⁴	150 (where possible)

- NOTES:
- Vertical clearances apply where pipelines cross other utility services, except in the case of water/sewer mains when a vertical separation shall always be maintained, even when the pressure sewer and water main are parallel. The pressure sewer should always be located below the water main to minimise the possibility of backflow contamination in the event of a pressure main break.
 - Water mains includes mains supplying both potable and recycled water.
 - For areas with existing water reticulation, clearances can be further reduced to 600mm with the approval of the water authority.
 - Clearances can be further reduced to 150mm for distances up to 2m when passing installations such as poles, pits, and small structures, providing the structures is not destabilised in the process.
 - Clearances from kerbs shall be measured from the nearest point of the kerb. For water/sewer <DN375, clearances from kerbs can be progressively reduced until the minimum of 150mm is reached for water/sewer <DN200.
 - Where a parallel sewer is at minimum vertical clearance (lower than the water main (500mm), maintain a minimum horizontal of 1000mm. This minimum clearance can be progressively reduced to 600mm as the vertical clearance is increased to 150mm.
 - For pressure sewer laterals, minimum vertical clearances may be reduced to 150mm providing there is no joint in the lateral within 500mm of either side of the service being crossed.
 - An additional clearance from high voltage electrical installations should be maintained above the conduits or cables to allow for a protective barrier and marking to be provided.
 - Water mains should always cross over sewers and stormwater drains. For cases where this is not alternative and the main must cross under the sewer, the design shall nominate an appropriate protection treatment (joint-free in the vicinity of the sewer).

⁴ SHOULD THE RECOMMENDED CLEARANCES NOT BE ACHIEVED, NOTIFICATION SHALL BE CONVEYED TO THE BOX HILL WATER REPRESENTATIVE IN WRITING.

SEWER NOTES

- 1. ALL WORKS SHALL BE CONSTRUCTED IN ACCORDANCE WITH THE DESIGN DRAWINGS, FLOW SYSTEMS SUPPLEMENTARY MANUAL TO W.S.A.A., PRESSURE SEWERAGE CODE OF AUSTRALIA WSA 07-2007 VERSION 1.1 & POLYETHYLENE PIPELINE CODE WSA 01-2004.
- 2. ALL EQUIPMENT, MATERIALS & ACCESSORIES USED IN THIS CONTRACT SHALL BE NEW & SHALL COMPLY WITH FLOW SYSTEMS REQUIREMENTS. BUTT FUSION FITTINGS DENOTED HEREWITH HAVE BEEN DERIVED FROM THE GEORG FISCHER PIPING SYSTEMS BUTT FUSION PRODUCT RANGE. ELECTROFUSION FITTINGS DENOTED HEREWITH HAVE BEEN DERIVED FROM THE PLASSON POLYETHYLENE PIPING SYSTEMS' PRODUCT RANGE.
- 3. ALL SERVICES SHOWN ARE INDICATIVE ONLY. A CURRENT SERVICES SEARCH & SITE CHECK OF ALL EXISTING SERVICES WILL BE REQUIRED PRIOR TO COMMENCEMENT OF ANY WORKS. THE CONSTRUCTOR IS TO DETERMINE LEVELS & LOCATIONS EXISTING SERVICES IN THE VICINITY OF THE CONSTRUCTION SITE AND ANY CONSTRUCTED STRUCTURES FOR PROPOSED SERVICES, SUCH AS DUCTING FOR WATER OR ELECTRICITY WITHIN THE SUBDIVISION. THE CONTRACTOR MUST ENSURE ALL SERVICES ARE LOCATED BY THE RELEVANT AUTHORITY PRIOR TO COMMENCEMENT OF WORKS.
- 4. PRESSURE SEWER MAINS SHALL BE BLACK POLYETHYLENE (PE100 PN16) WITH A CREAM STRIPE AS PER WSA 07-2007 & FLOW SYSTEMS SUPPLEMENTARY MANUAL TO W.S.A.A.
- 5. ALL POLYETHYLENE MAINS ≤DN200 SHALL BE JOINED BY ELECTROFUSION TECHNIQUES IN ACCORDANCE WITH THE MANUFACTURERS REQUIREMENTS. ALL POLYETHYLENE MAINS >DN200 SHALL BE JOINED BY BUTTWELD TECHNIQUES IN ACCORDANCE WITH THE MANUFACTURERS REQUIREMENTS
- 6. MAIN TO BE LAID GENERALLY AS INDICATED IN SERVICE ALLOCATION DIAGRAMS. INSTRUCTION NOTES SHALL TAKE PRECEDENCE OVER DIAGRAMS WHERE PROVIDED. 600mm HORIZONTAL CLEARANCE TO BE MAINTAINED BETWEEN ALL SEWER & WATER MAINS. MINIMUM PIPE COVER SHALL BE 800mm IN FOOTWAYS & FOR ROADWAYS. MAXIMUM PIPE COVER SHALL GENERALLY BE 15m, WHERE COVER FOR A TRENCHED INSTALLATION EXCEEDS 15m, BUT LESS THAN 2.5m, THE MAIN AS A MINIMUM SHALL BE EMBEDDED IN STABILISED SAND. THE CONTRACTOR SHALL ENSURE THAT ALL PRESSURE SEWER & RECYCLED WATER MAINS HAVE SUFFICIENT VERTICAL SEPARATION AS PER THE CLEARANCE TABLE ADJACENT.
- 7. MAINS CROSSING UNDER EXISTING DRIVEWAYS (SEALED, PAVED OR DECORATIVE) SHALL BE CONDUCTED BY UNDER BORING ONLY UNLESS PERMISSION IS GRANTED BY THE AFFECTED PROPERTY OWNER.
- 8. MAINS WITHIN 2m OF ELECTRICITY OR POWER POLES SHALL BE CONDUCTED BY BORING TECHNOLOGY (UNLESS AGREED TO BY THE BOX HILL WATER REPRESENTATIVE).
- 9. ALL PIPE BEDDING MATERIAL SHALL COMPLY WITH WSAA PRODUCT SPECIFICATION WSA-PS350 & WSA-PS351.
- 10. ALL BENDS SHALL BE ELECTROFUSION OR BUTTWELD SWEEP BENDS. FABRICATED BENDS SHALL NOT BE USED IN LIEU OF KNUCKLE ELBOWS ARE NOT PERMITTED.
- 11. MINIMUM BENDING RADIUS FOR PN16 PE100 (SDR11) SHALL BE $20 \times DN$ (ie. DN400 R8.0m, DN250 R5.0m, DN200 R4.0m, DN160 R3.2m, DN125 R2.5m, DN90 R1.8m, DN75 R1.5m, DN63 R1.3m, DN50 R1.0m, DN40 R0.8m)
- 12. ALL HOUSE SERVICE LATERALS SHALL BE DN40 (PE100 PN16).
- 13. FLUSHING PITS SHALL CONFORM WITH FLOW SYSTEMS STANDARD DRAWINGS. REFER TO FLOW SYSTEMS WEBSITE FOR CURRENT VERSION.
SMALL MAINS (< DN110)
http://flowsystems.com.au/governance/Land_Housing/PSS-1017A-FS.pdf
LARGE MAINS (> DN110)
http://flowsystems.com.au/governance/Land_Housing/PSS-1017B-FS.pdf
- 14. LOCALISED DEEPENING OF MAINS MAY BE REQUIRED TO FACILITATE AIR VALVE INSTALLATION. THE CONTRACTOR SHALL ENSURE THAT THE AIR VALVE OFFTAKE IS LOCATED AT A HIGH POINT (NATURAL OR ARTIFICIAL) IN THE MAIN (ie. MAIN SHALL GRADE DOWNWARDS EITHER SIDE OF THE AIR VALVE).
- 15. DETECTABLE MARKING TAPE SHALL BE LAID ON TOP OF THE PIPE EMBEDMENT MATERIAL BEFORE BACKFILLING & CONNECTED TO SURFACE VALVES.
- 16. ALL SURFACE FITTINGS LOCATED IN TRAFFICABLE AREAS (ie. ROADWAYS, PATHS etc) SHALL HAVE HEAVY DUTY SURROUNDS INSTALLED.
- 17. DURING CONSTRUCTION, ALL OPEN ENDS OF PIPE SHALL BE CAPPED OFF TO PREVENT ENTRY OF FOREIGN MATTER.
- 18. ALL VALVES SHALL BE RESILIENT SEATED SLUICE VALVES (CLOCKWISE CLOSING), SHALL BE RESTRAINED IN ACCORDANCE WITH WAT-1207 & SHALL COMPLY WITH FLOW SYSTEMS STANDARD DRAWING PSS-1015-FS.
- 19. ALL MAINS SHALL BE TESTED IN ACCORDANCE WITH WSA 07-2007 Version 1.1.
- 20. FOR LOTS WITH TANKS IN THE REAR, 1 x 25mm INSTRUMENTATION CONDUIT (ORANGE) AND 1 x 25mm ELECTRICAL CONDUIT (ORANGE) (WITH DRAW WIRES) SHALL BE INSTALLED FROM THE COLLECTION TANK TO WATER METERS. THE CONDUITS SHALL BE LAID IN A COMMON TRENCH WITH THE SEWERAGE AND MAINTAIN A MINIMUM HORIZONTAL CLEARANCE OF 400mm.
- 21. THE CONSTRUCTOR SHALL PROVIDE BOX HILL WATER WITH MINIMUM OF 7 DAYS NOTICE IN WRITING OF INTENT TO CONNECT NEW MAINS TO EXISTING INFRASTRUCTURE. CONNECTIONS ARE NOT PERMITTED UNTIL COMPLIANT TEST RESULTS HAVE BEEN PROVIDED & CONFIRMATION IS PROVIDED BY THE BOX HILL WATER REPRESENTATIVE.
- 22. UPON COMPLETION OF WORKS, ALL SURFACES MUST BE RESTORED AS CLOSE AS POSSIBLE, TO THE CONDITION THAT EXISTED PRIOR TO COMMENCEMENT OF WORK.
- 23. PERMISSION OF ENTRY MUST BE OBTAINED BY THE CONTRACTOR FROM THE OWNER/OCCUPIER PRIOR TO COMMENCEMENT OF WORK IN PRIVATE PROPERTY.
- 24. BURIED FITTINGS ARE NOT TO BE BACKFILLED UNTIL W.A.C. DETAILS HAVE BEEN OBTAINED & APPROVAL FOR BACKFILLING GIVEN BY THE BOX HILL WATER REPRESENTATIVE. THE CONTRACTOR SHALL PROVIDE M.G.A. COORDINATED WORK-AS-CONSTRUCTED INFORMATION REGARDING THE INSTALLATION OF ALL BURIED FITTINGS.
- 25. THE MINIMUM NUMBER OF COMPACTION TESTS REQUIRED TO SATISFY THE PRESSURE SEWER CODE OF AUSTRALIA (CLAUSE 21.3.4) ARE:
TRAFFICABLE:
PIPE EMBEDMENT ZONE: NIL TRENCH FILL ZONE: NIL
NON-TRAFFICABLE:
PIPE EMBEDMENT ZONE: NIL TRENCH FILL ZONE: 1 TEST / 100m (32 Tests)
- 26. BOUNDARY KITS (COMPLETE) SHALL BE NOV SUPPLIED (NOV PSS-BK4). NOV 900L COLLECTION TANK (PSS-VMS150-PRIL) SHALL BE INSTALLED WITH BOUNDARY KIT (REFER FLOW SYSTEMS STANDARD DRAWINGS PSS-1112-FS & PSS-1113-FS). PUMP TO BE INSTALLED BY OTHERS.
- 27. ALL MAINS (UP TO THE BOUNDARY KIT) SHALL BE PRESSURE TESTED TO 1600 kPa.
- 28. ALL MAINS SHALL BE FLUSHED WITH WATER TO REMOVE ANY DEBRIS PRIOR TO COMMISSIONING.
- 29. SURFACE IDENTIFICATION MARKERS ARE TO BE PROVIDED TO BOX HILL WATER REQUIREMENTS.
- 30. ROPE OFF ALL PRESSURE SEWER UNITS & FLUSHING POINTS TO LIMIT DAMAGE DURING CONSTRUCTION.
- 31. PRESSURE TRANSMITTER TO BE MEASUREX MRB21 GENERAL PURPOSE TRANSMITTER WITH MICROSPIDER LOGGING TELEMETRY AND ALARM PER FLOW SYSTEMS REQUIREMENTS.
- 32. WORK-AS-CONSTRUCTED DOCUMENTATION SHALL BE PROVIDED BY THE CONTRACTOR STRICTLY IN ACCORDANCE WITH THE FLOW SYSTEMS Q.A. SUBMISSION CHECKLIST.

REFER GENERAL ARRANGEMENT SHEETS FOR PIPE SCHEDULE

FLOW SYSTEMS STANDARD DRAWINGS CAN BE FOUND AT THE FOLLOWING ADDRESS:

<https://askus.flowsystems.com.au/hc/en-us/articles/210615393--Standard-Drawings>

RECYCLED WATER NOTES

WORK-AS-CONSTRUCTED

- 1. ALL WORKS SHALL BE CONSTRUCTED IN ACCORDANCE WITH THE DESIGN DRAWINGS, FLOW SYSTEMS SUPPLEMENTARY MANUAL TO W.S.A.A. & WSA 03-2011-3.1 (SYDNEY WATER WATER EDITION - 2014).
- 2. POTABLE WATER SHALL BE UTILISED FOR FIRE FIGHTING PURPOSES.
- 3. ALL EQUIPMENT, MATERIALS & ACCESSORIES USED IN THIS CONTRACT SHALL BE NEW, SHALL CONFORM WITH THE APPROPRIATE CURRENT AUSTRALIAN STANDARDS & SHALL COMPLY WITH FLOW SYSTEMS REQUIREMENTS.
- 4. ALL SERVICES SHOWN ARE INDICATIVE ONLY. A CURRENT SERVICES SEARCH & SITE CHECK OF ALL EXISTING SERVICES WILL BE REQUIRED PRIOR TO COMMENCEMENT OF ANY WORKS. THE CONSTRUCTOR IS TO DETERMINE LEVELS & LOCATIONS EXISTING SERVICES IN THE VICINITY OF THE CONSTRUCTION SITE AND ANY CONSTRUCTED STRUCTURES FOR PROPOSED SERVICES, SUCH AS DUCTING FOR WATER OR ELECTRICITY WITHIN THE SUBDIVISION. THE CONTRACTOR MUST ENSURE ALL SERVICES ARE LOCATED BY THE RELEVANT AUTHORITY PRIOR TO COMMENCEMENT OF WORKS.
- 5. THE CONSTRUCTOR SHALL VERIFY WITH THE SITE SURVEYOR THE POSITION & LEVEL OF ALL EXISTING & PROPOSED BOUNDARIES PERTINENT TO THE INFRASTRUCTURE INSTALLATIONS.
- 6. MAINS TO BE LAID GENERALLY AS INDICATED IN SERVICE ALLOCATION DIAGRAMS. INSTRUCTION NOTES SHALL TAKE PRECEDENCE OVER DIAGRAMS WHERE PROVIDED. 600mm HORIZONTAL CLEARANCE TO BE MAINTAINED BETWEEN ALL SEWER & WATER MAINS. MINIMUM PIPE COVER SHALL BE 600mm IN FOOTWAYS (TYPE B EMBEDMENT: WAT-1202-VI) & FOR ROADWAYS (TYPE L EMBEDMENT: WAT-1204-VI). MAXIMUM PIPE COVER SHALL GENERALLY BE 15m, WHERE COVER FOR A TRENCHED INSTALLATION EXCEEDS 15m, BUT IS LESS THAN 2.5m, THE MAIN AS A MINIMUM SHALL BE EMBEDDED IN STABILISED SAND. THE CONTRACTOR SHALL ENSURE THAT ALL RECYCLED WATER & PRESSURE SEWER MAINS HAVE SUFFICIENT VERTICAL SEPARATION AS PER THE CLEARANCE TABLE ADJACENT.
- 7. ALL RECYCLED WATER MAINS SHALL BE LILAC mPVC (PN16). DIFFERENTIATION OF POTABLE & RECYCLED WATER SYSTEMS SHALL BE AS PER TABLE 4.1 WSA03-2011 WITH BOTH SERVICES BEING CLASSIFIED AS WATERMAINS. RECYCLED WATER MAINS SHALL ALWAYS BE LOWER THAN POTABLE MAINS. 150mm VERTICAL CLEARANCE BETWEEN POTABLE WATER & RECYCLED WATER MAINS SHALL BE PROVIDED.
- 8. MAXIMUM JOINT DEFLECTION SHALL BE IN ACCORDANCE WITH THE MANUFACTURERS RECOMMENDATIONS.
- 9. LOCALLY LOWER PIPEWORK IN VICINITY OF STOP VALVES TO ENSURE SUFFICIENT COVER IS MAINTAINED OVER VALVES. LOWERING OF PIPEWORK SHALL ACHIEVED OVER A NUMBER OF PIPE LENGTHS EITHER SIDE OF VALVES TO ELIMINATE ANY SHARP DEFLECTIONS.
- 10. ALL PIPE BEDDING MATERIAL SHALL COMPLY WITH WSAA PRODUCT SPECIFICATION PS-350, 368 & 369. GEOTECHNICAL CONDITIONS SHOULD BE ASSESSED DURING CONSTRUCTION BY THE CONTRACTOR IN ASSOCIATION WITH THE BOX HILL WATER REPRESENTATIVE TO DETERMINE THE NEED TO MODIFY EMBEDMENT/TRENCHFILL TYPE & THE ROAD FOR TRENCH DRAINAGE/BULKHEADS.
- 11. DURING CONSTRUCTION, ALL OPEN ENDS OF PIPES SHALL BE CAPPED OFF TO PREVENT ENTRY OF FOREIGN MATTER.
- 12. HYDRANTS, STOP VALVES & ALL OTHER FITTINGS SHALL BE THE SAME SIZE AS THROUGH WATER MAIN & ANTICLOCKWISE CLOSING.
- 13. HYDRANTS MUST NOT BE INSTALLED IN POTENTIAL DRIVEWAY LOCATIONS. HYDRANTS & WATER SERVICES SHALL BE NOMINALLY AT LEAST 5m FROM EACH BOUNDARY OR ON BOUNDARIES. WHERE POSSIBLE, FITTINGS SHALL BE LOCATED BEHIND KERB INLET PITS.
- 14. THRUST BLOCKS SHALL BE INSTALLED IN ACCORDANCE WITH WAT-1205.
- 15. ALL PROPERTY (MAIN TO METER) SERVICE CONNECTIONS SHALL BE CONSTRUCTED STRICTLY IN ACCORDANCE FLOW SYSTEMS REQUIREMENTS. REFER TO FLOW SYSTEMS WEBSITE FOR CURRENT VERSIONS.
SINGLE SERVICE http://flowsystems.com.au/governance/Land_Housing/WAT-1854-FS.pdf
DUAL SERVICE http://flowsystems.com.au/governance/Land_Housing/WAT-1855-FS.pdf
- 16. PROPERTY SERVICE CONNECTIONS SHALL BE FLUSHED & LOCKED (BY THE BOX HILL WATER REPRESENTATIVE) FOLLOWING SUCCESSFUL PRESSURE TESTING.
- 17. SURFACE FITTINGS LOCATED IN TRAFFICABLE AREAS (ie. ROADWAYS, PATHS etc) SHALL HAVE HEAVY DUTY SURROUNDS INSTALLED.
- 18. ALL MAINS SHALL BE TESTED IN ACCORDANCE WITH WSA 03-2011-3.1 (SYDNEY WATER EDITION - 2014).
- 19. ALL MAINS SHALL BE FLUSHED WITH WATER TO REMOVE ANY DEBRIS PRIOR TO COMMISSIONING.
- 20. WATER QUALITY TESTING SHALL BE IN ACCORDANCE WITH WSA 03-2011-3.1 (SYDNEY WATER EDITION - 2014: CLAUSE 19.7).
- 21. THE CONSTRUCTOR SHALL PROVIDE BOX HILL WATER WITH MINIMUM OF 7 DAYS NOTICE IN WRITING OF INTENT TO CONNECT NEW MAINS TO EXISTING INFRASTRUCTURE. CONNECTIONS ARE NOT PERMITTED UNTIL COMPLIANT TEST RESULTS HAVE BEEN PROVIDED & CONFIRMATION IS PROVIDED BY THE BOX HILL WATER REPRESENTATIVE.
- 22. UPON COMPLETION OF WORKS, ALL SURFACES MUST BE RESTORED AS CLOSE AS POSSIBLE, TO THE CONDITION THAT EXISTED PRIOR TO COMMENCEMENT OF WORK.
- 23. PERMISSION OF ENTRY MUST BE OBTAINED BY THE CONTRACTOR FROM THE OWNER/OCCUPIER PRIOR TO COMMENCEMENT OF WORK IN PRIVATE PROPERTY.
- 24. BURIED FITTINGS ARE NOT TO BE BACKFILLED UNTIL W.A.C. DETAILS HAVE BEEN OBTAINED & APPROVAL FOR BACKFILLING GIVEN BY THE BOX HILL WATER REPRESENTATIVE. THE CONTRACTOR SHALL PROVIDE M.G.A. COORDINATED WORK-AS-CONSTRUCTED INFORMATION REGARDING THE INSTALLATION OF ALL BURIED FITTINGS.
- 25. THE MINIMUM NUMBER OF COMPACTION TESTS REQUIRED TO SATISFY THE WATER SUPPLY CODE OF AUSTRALIA ARE:
TRAFFICABLE:
PIPE EMBEDMENT ZONE: NIL TRENCH FILL ZONE: NIL
NON-TRAFFICABLE:
PIPE EMBEDMENT ZONE: NIL TRENCH FILL ZONE: 1 TEST / 100m (32 Tests)

TESTING SHALL BE IN ACCORDANCE WITH TABLE 16.1 & 17.1 OF THE WATER SUPPLY CODE OF AUSTRALIA
- 26. SURFACE IDENTIFICATION MARKERS ARE TO BE PROVIDED TO BOX HILL WATER REQUIREMENTS.
- 27. PRESSURE TRANSMITTER TO BE MEASUREX MRB21 GENERAL PURPOSE TRANSMITTER WITH MICROSPIDER LOGGING TELEMETRY AND ALARM PER FLOW SYSTEMS REQUIREMENTS.
- 28. WORK-AS-CONSTRUCTED DOCUMENTATION SHALL BE PROVIDED BY THE CONTRACTOR STRICTLY IN ACCORDANCE WITH THE FLOW SYSTEMS Q.A. SUBMISSION CHECKLIST.

Precinct H Development Stages

- Stage 1
- Stage 2
- Stage 3
- Stage 4

PRESSURE SEWER PIPE SCHEDULE

SIZE	TYPE	CLASS	LENGTH
DN110	PE100	PN16	19.7
DN90	PE100	PN16	534.1
DN75	PE100	PN16	419.5
DN63	PE100	PN16	761.3
DN50	PE100	PN16	1,558.3
DN40	PE100	PN16	1,641.7
TOTAL			4,934.6

ROSE ATKINS RIMMER (Infrastructure) Pty. Ltd.

RAR

WATER RELATED INFRASTRUCTURE DESIGN AND MANAGEMENT

142 SUNNYHOLT ROAD, BLACKTOWN
P.O. BOX 6745, BLACKTOWN N.S.W. 2148
PH: (02) 9853 0200 FAX: (02) 9671 7399

Quality
Endorsed
Company

PRESSURE SEWER GENERAL ARRANGEMENT

DRAWN: K.GAO	DESIGNED: K.GAO	REVIEWED: V.VIKSNE	VERIFIED: D.SHEATHER
SCALE: -	DATUM: -	U.S.D. REFERENCE: 108 L2-L3	DATE OF ISSUE: 5/2/2018

SHEET 3 OF 15

VERSION:
WAC


4/23645/H2

Box Hill + Water

PRESSURE SEWER LEGEND

	STOP VALVE
	STOP VALVE (NORMALLY CLOSED)
	TAPER
	FLUSHING POINT
	TEMPORARY FLUSHING POINT
	PROPERTY BOUNDARY KIT
	COLLECTION TANK (STANDARD)
	COLLECTION TANK (WITH 300mm RISERS)
	COLLECTION TANK (WITH 2x300mm RISERS)
	CONTROL/ALARM PANEL
	ELECTRICAL CABLES
	FLOW METER
	AIR VALVE
	PRESSURE MONITORING POINT
	REMOTE MONITORED PRESSURE TRANSDUCER
	VERTICAL DEFLECTION


WORK-AS-CONSTRUCTED

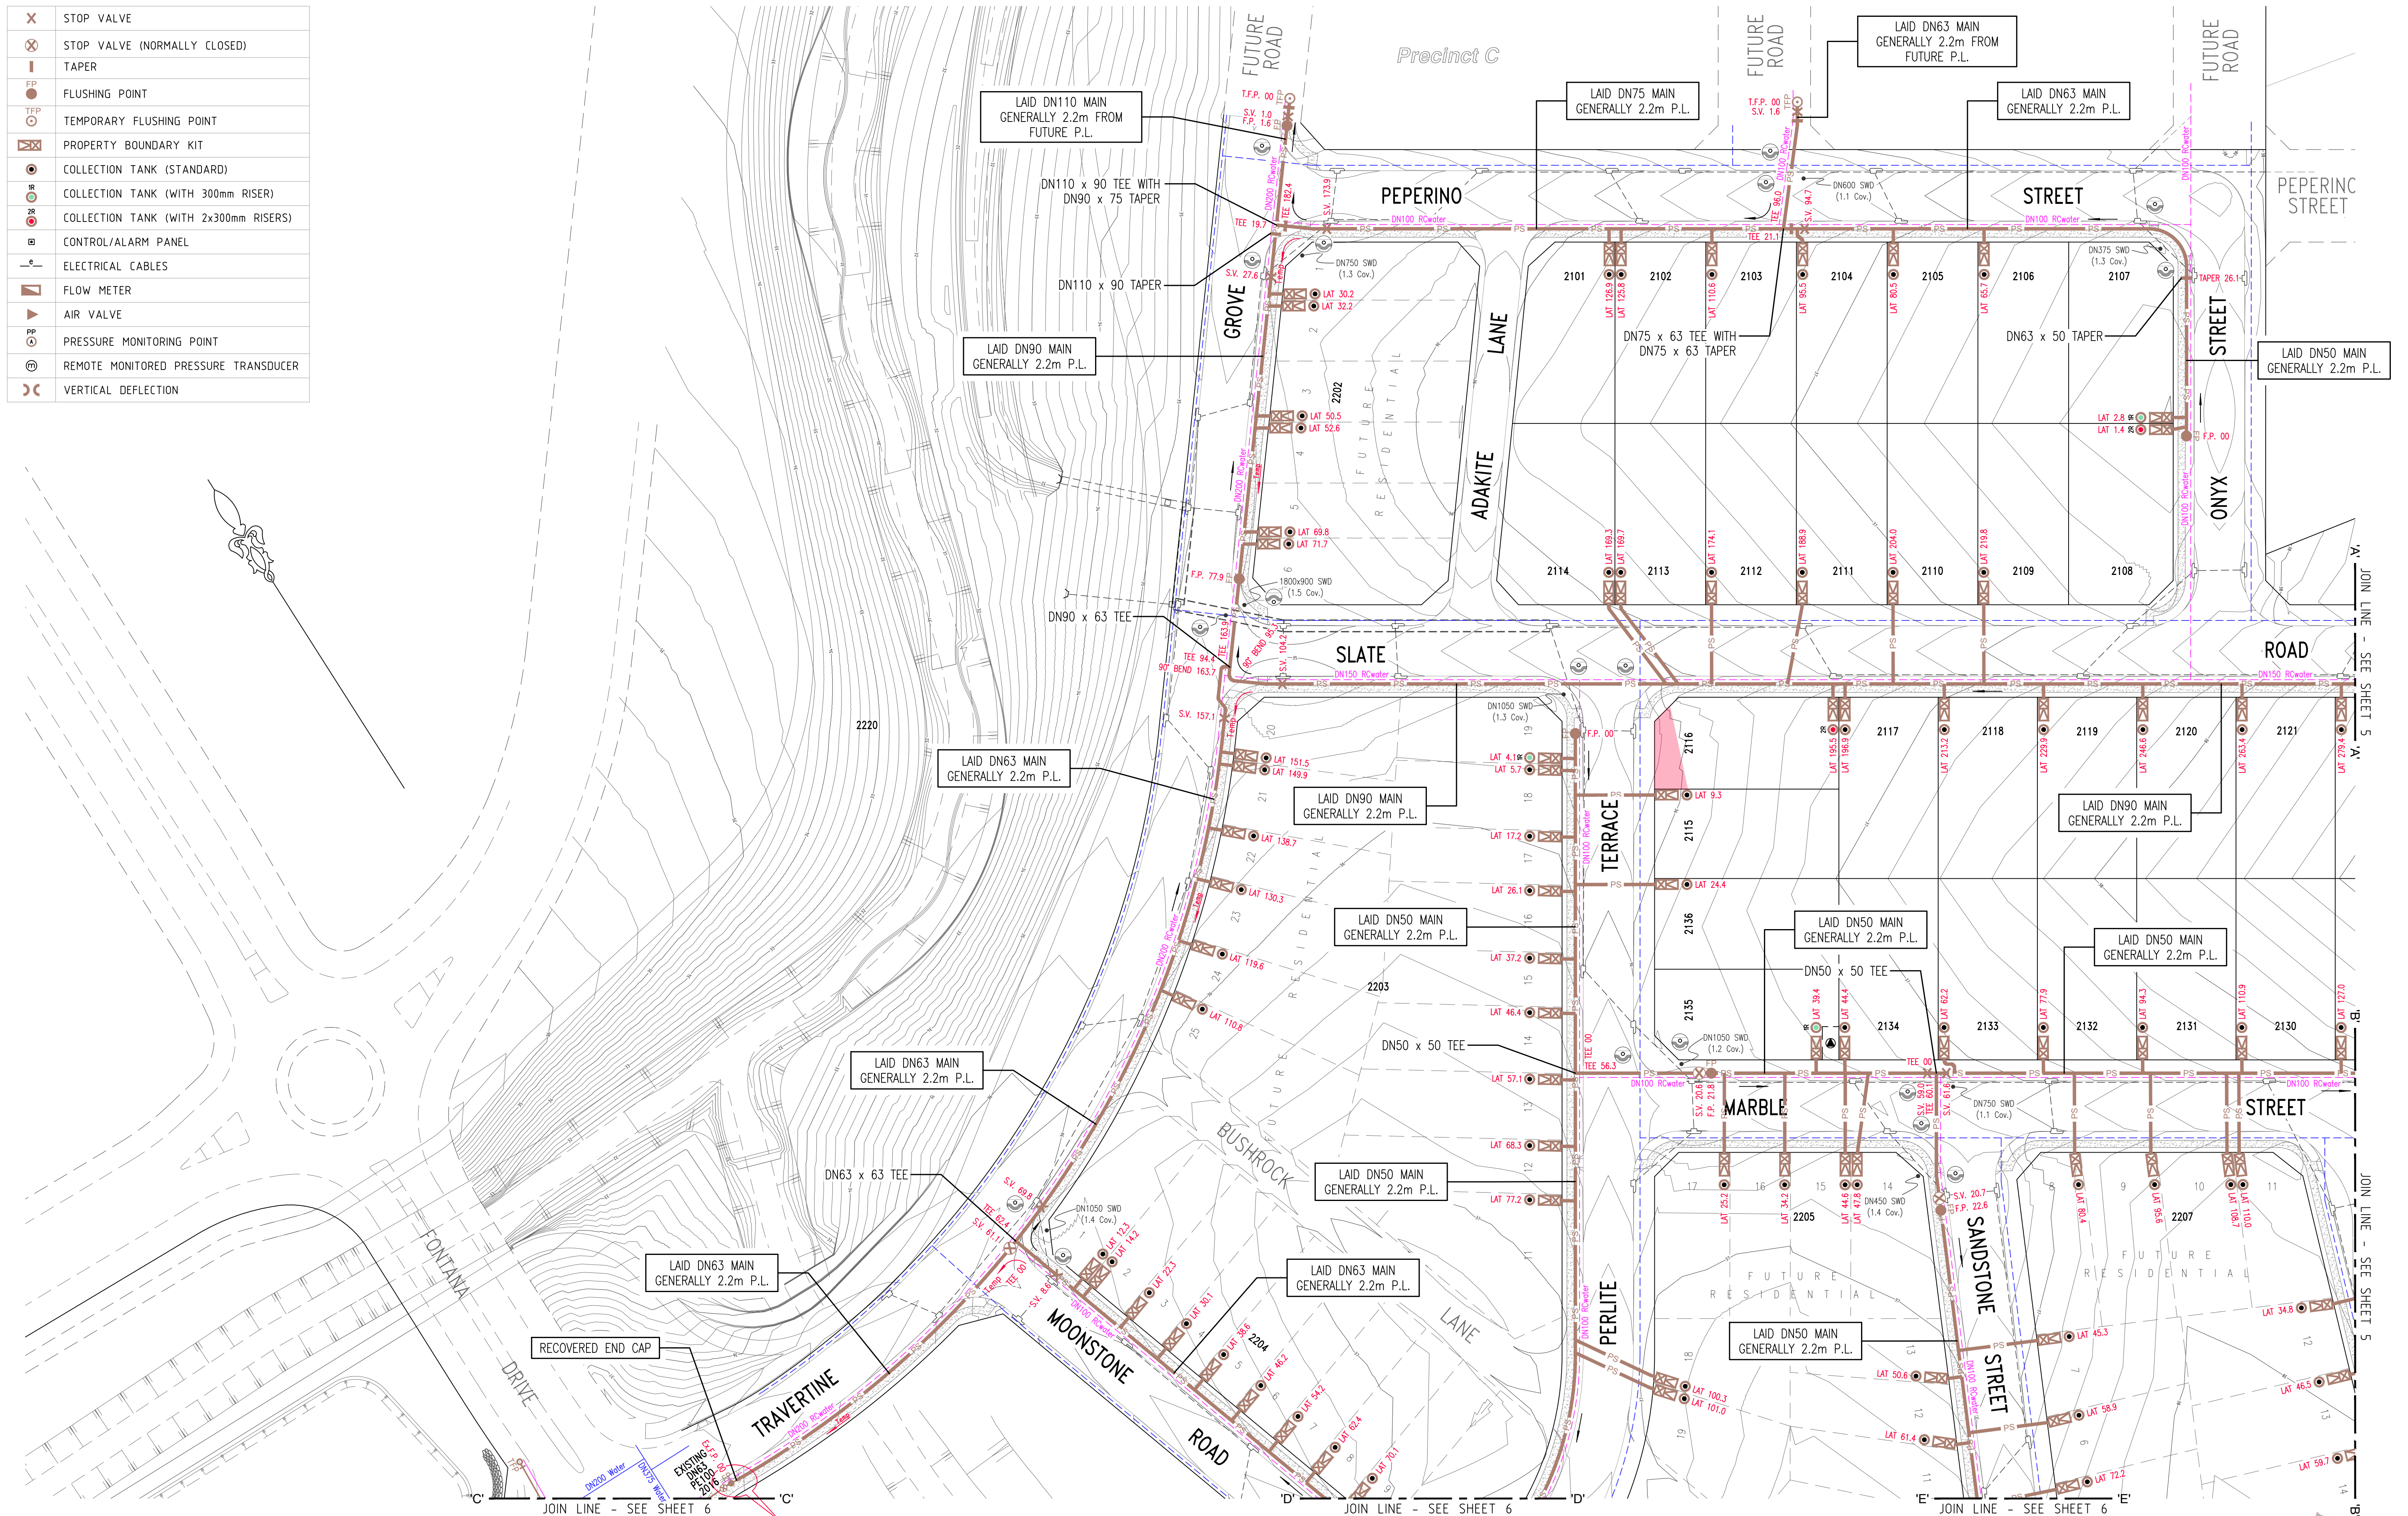

NOTE 1: VALVE SHALL NORMALLY BE CLOSED. VALVE TO BE OPENED TEMPORARILY TO FACILITATE AN INTERIM CHANGE IN FLOW DIRECTION UNTIL PRECINCT C & DOWNSTREAM MAINS ARE OPERATIONAL (THEN CLOSE).

REFER NOTE 1


ESMT FOR PADMOUNT SUBSTATION 2.75 W.

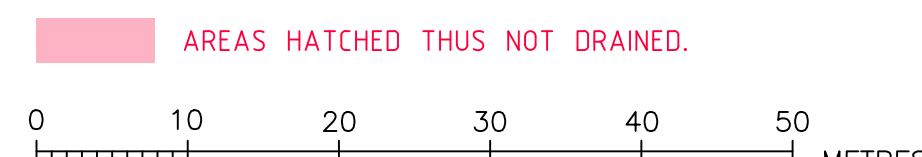

ROSE ATKINS RIMMER (Infrastructure) Pty. Ltd.
 WATER RELATED INFRASTRUCTURE DESIGN AND MANAGEMENT
 142 SUNNYHOLT ROAD, BLACKTOWN
 P.O. BOX 6745, BLACKTOWN N.S.W. 2148
 PH: (02) 9853 0200 FAX: (02) 9671 7399



PRESSURE SEWER DETAIL PLAN 1				SHEET 4 OF 15		WAC
DESIGNED BY	K.GAO	REVIEWED BY	V.VIKSNE	DATE	5/2/2018	4/23645/H2
DRAWN BY	K.GAO	DATE	A.H.D.	DATE OF ISSUE	5/2/2018	
SCALE	1:500	DATA	A.H.D.	DATE OF ISSUE	5/2/2018	

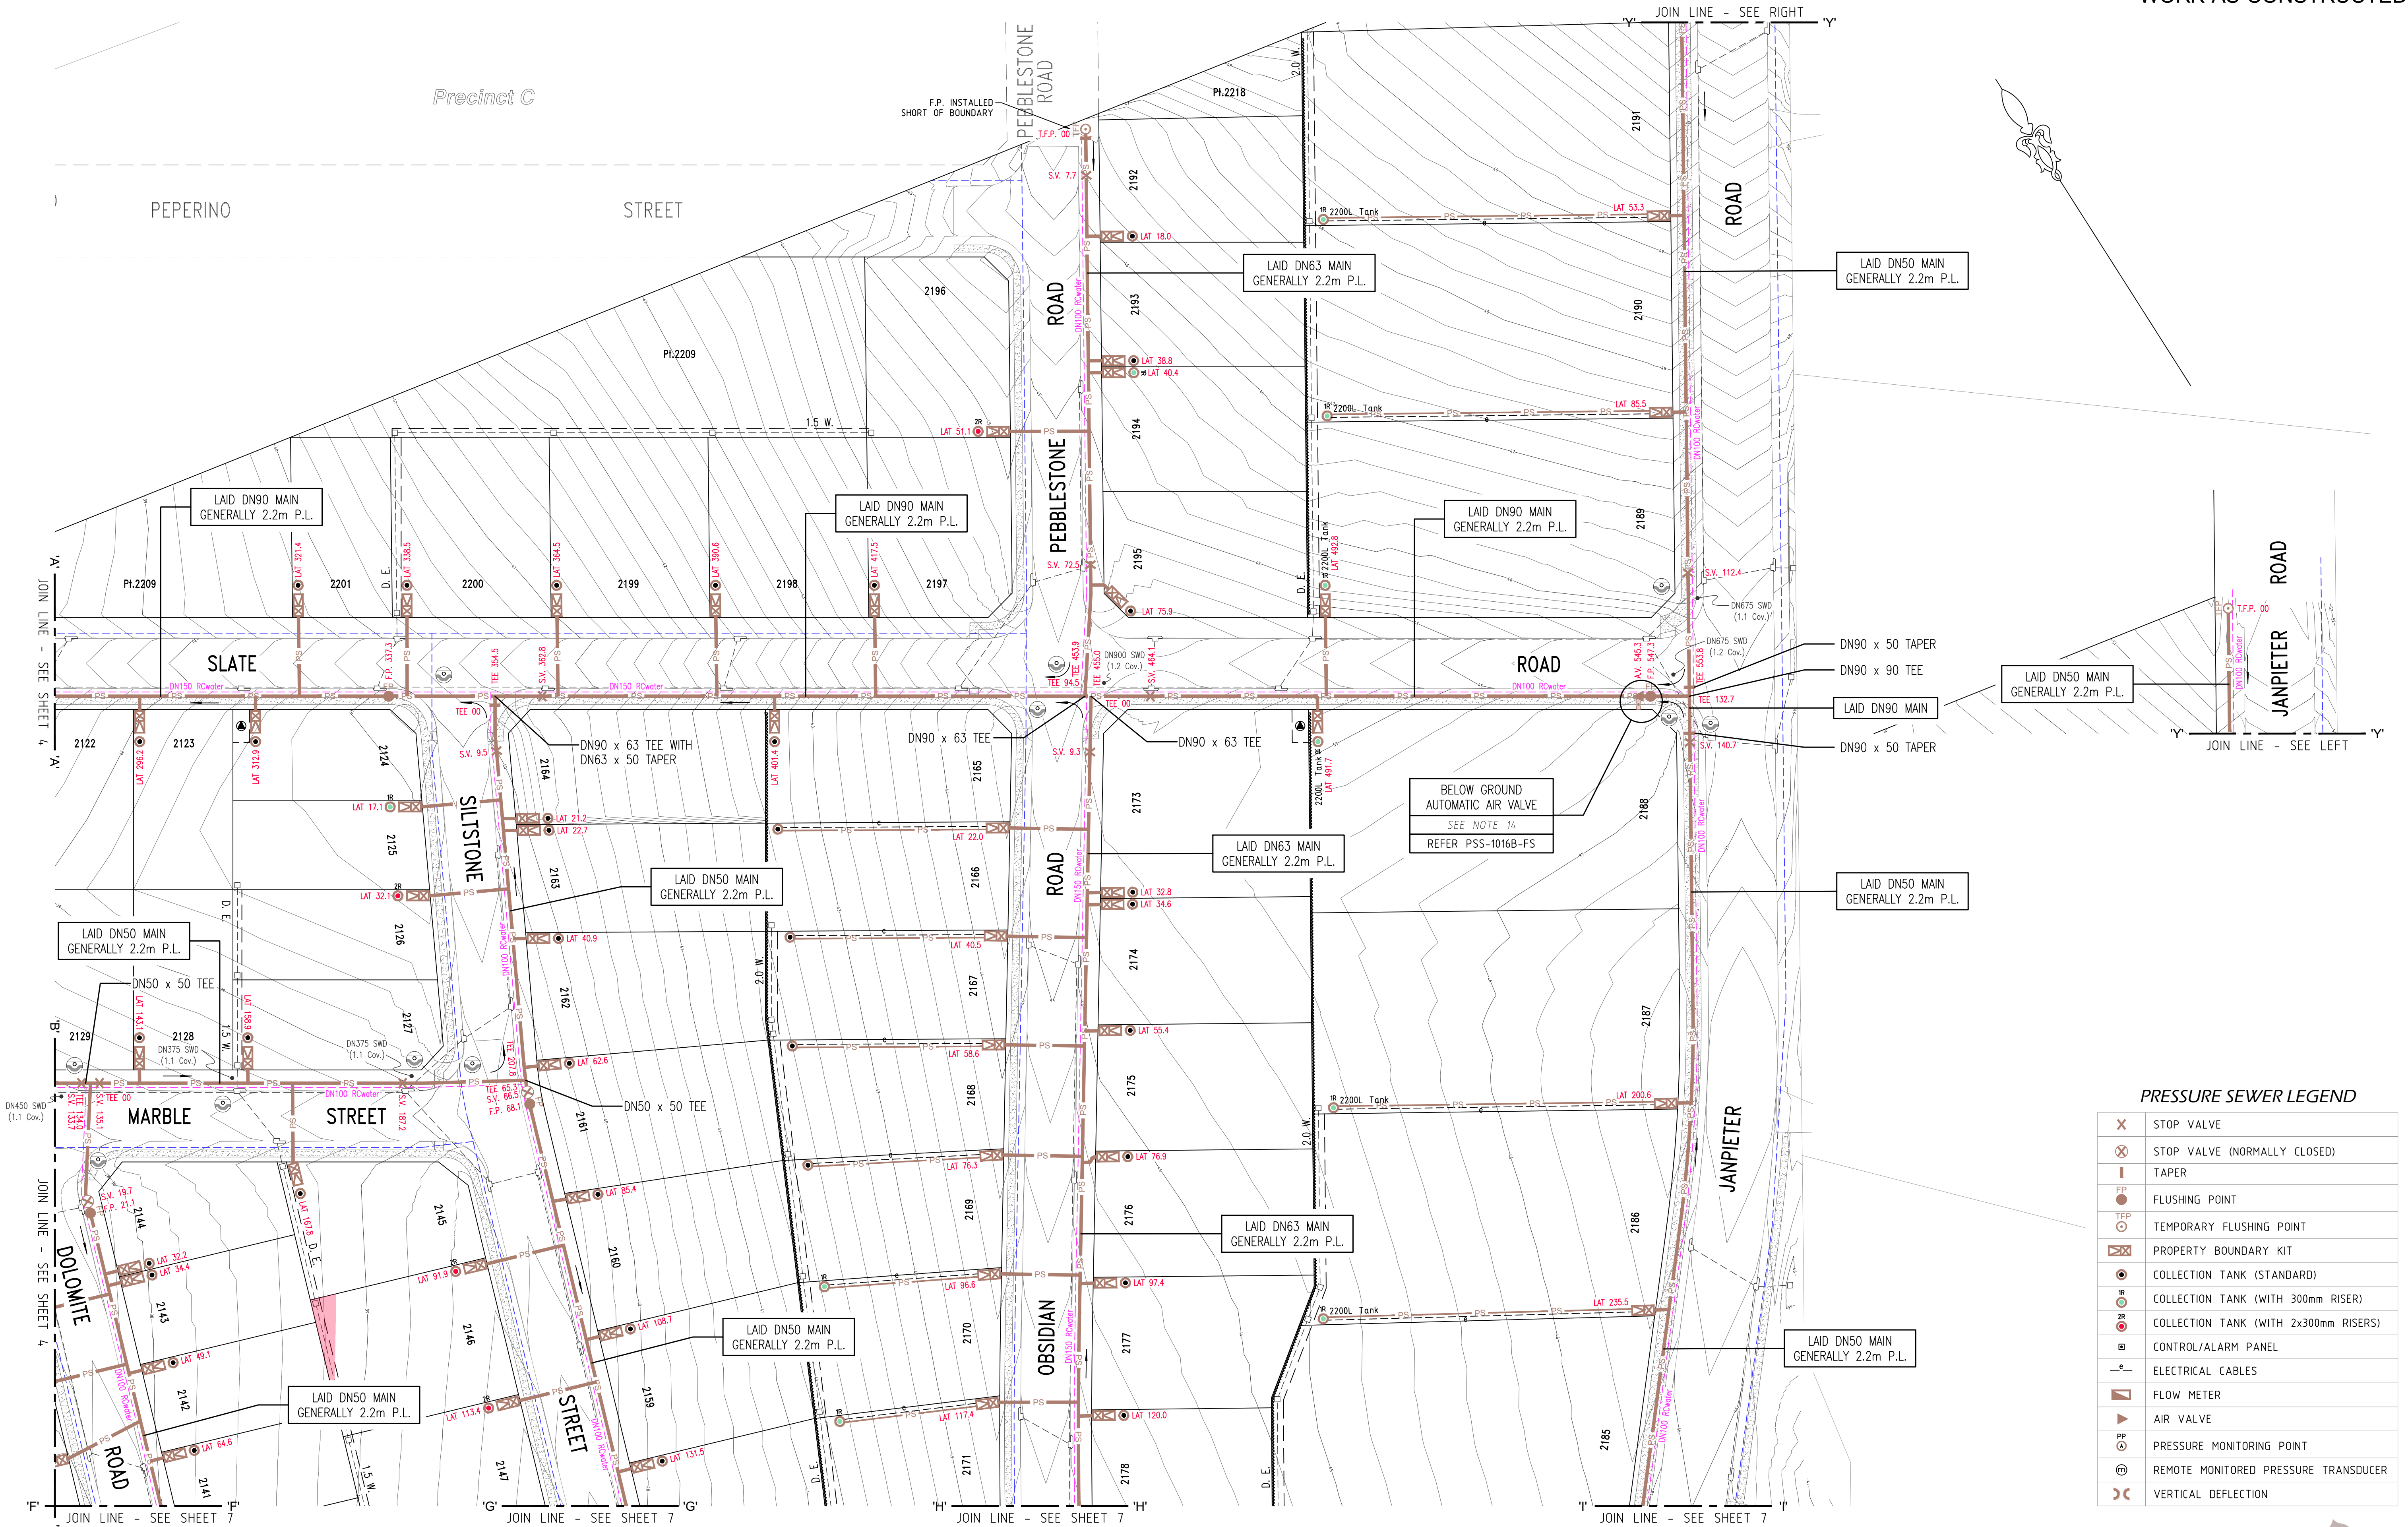


PRESSURE SEWER LEGEND

	STOP VALVE
	STOP VALVE (NORMALLY CLOSED)
	TAPER
	FLUSHING POINT
	TEMPORARY FLUSHING POINT
	PROPERTY BOUNDARY KIT
	COLLECTION TANK (STANDARD)
	COLLECTION TANK (WITH 300mm RISER)
	COLLECTION TANK (WITH 2x300mm RISERS)
	CONTROL/ALARM PANEL
	ELECTRICAL CABLES
	FLOW METER
	AIR VALVE
	PRESSURE MONITORING POINT
	REMOTE MONITORED PRESSURE TRANSDUCER
	VERTICAL DEFLECTION

○ DENOTES LAY MAIN UNDER SERVICE
● DENOTES LAY MAIN OVER SERVICE

● ESMT FOR PADMOUNT SUBSTATION 2.75 W.

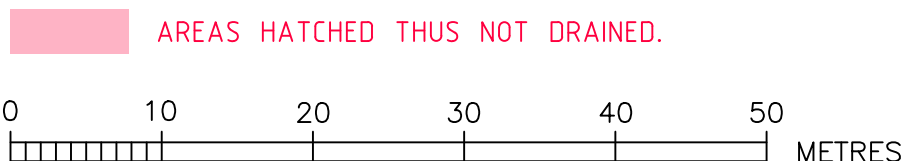

ROSE ATKINS RIMMER (Infrastructure) Pty. Ltd.

RAR WATER RELATED INFRASTRUCTURE DESIGN AND MANAGEMENT

142 SUNNYHOLT ROAD, BLACKTOWN
P.O. BOX 6745, BLACKTOWN N.S.W. 2148
PH: (02) 9853 0200 FAX: (02) 9671 7399

Box Hill + Water

PRESSURE SEWER DETAIL PLAN 2

DRAWN: K.GAO	DESIGNED: K.GAO	REVIEWED: V.VIKSNE	VERIFIED: D.SHEATHER
SCALE: 1:500	DATAN: A.H.D.	DATA REFERENCE: 108 L2-L3	DATE OF ISSUE: 5/2/2018

SHEET 5 OF 15

VERSION: WAC

4/23645/H2

NOTE 1: VALVE SHALL NORMALLY BE CLOSED.
VALVE TO BE OPENED TEMPORARILY TO FACILITATE
AN INTERIM CHANGE IN FLOW DIRECTION UNTIL
PRECINCT C AND DOWNSTREAM PS MAINS IS OPERATIONAL
(THEN CLOSE).

JOIN LINE - SEE SHEET 4

REFER NOTE 1

LAI D DN63 MAIN
GENERALLY 2.2m P.L.

DN63 x 50 TEE WITH
DN63 x 50 TAPER

LAI D DN50 MAIN
GENERALLY 2.2m P.L.

LAI D DN50 MAIN
GENERALLY 2.2m P.L.

LAI D DN50 MAIN
GENERALLY 2.2m P.L.

LAI D DN50 MAIN
GENERALLY 2.2m P.L.

LAI D DN75 MAIN
GENERALLY 2.2m P.L.


PRESSURE SEWER LEGEND

	STOP VALVE
	STOP VALVE (NORMALLY CLOSED)
	TAPER
	FLUSHING POINT
	TEMPORARY FLUSHING POINT
	PROPERTY BOUNDARY KIT
	COLLECTION TANK (STANDARD)
	COLLECTION TANK (WITH 300mm RISER)
	COLLECTION TANK (WITH 2x300mm RISERS)
	CONTROL/ALARM PANEL
	ELECTRICAL CABLES
	FLOW METER
	AIR VALVE
	PRESSURE MONITORING POINT
	REMOTE MONITORED PRESSURE TRANSDUCER
	VERTICAL DEFLECTION

DENOTES LAY MAIN UNDER SERVICE
 DENOTES LAY MAIN OVER SERVICE

ESMT FOR PADMOUNT
SUBSTATION 2.75 W.

AREAS HATCHED THUS NOT DRAINED.

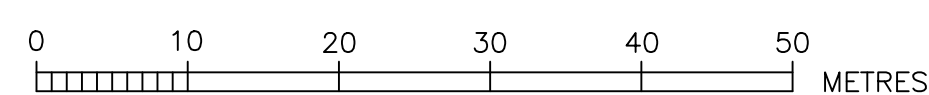

ROSE ATKINS RIMMER (Infrastructure) Pty. Ltd.
WATER RELATED INFRASTRUCTURE DESIGN AND MANAGEMENT
142 SUNNYHOLT ROAD, BLACKTOWN
P.O. BOX 6745, BLACKTOWN N.S.W. 2148
PH: (02) 9853 0200 FAX: (02) 9671 7399



PRESSURE SEWER DETAIL PLAN 3


DESIGNED K.GAO	REVIEWED K.GAO	VERIFIED V.VIKSNE	DATE OF ISSUE 5/2/2018
SCALE 1:500	DATAN A.H.D.	W.A.D. REFERENCE 108 L2-L3	DATE OF ISSUE 5/2/2018

SHEET 6 OF 15


WAC

4/23645/H2

WORK-AS-CONSTRUCTED

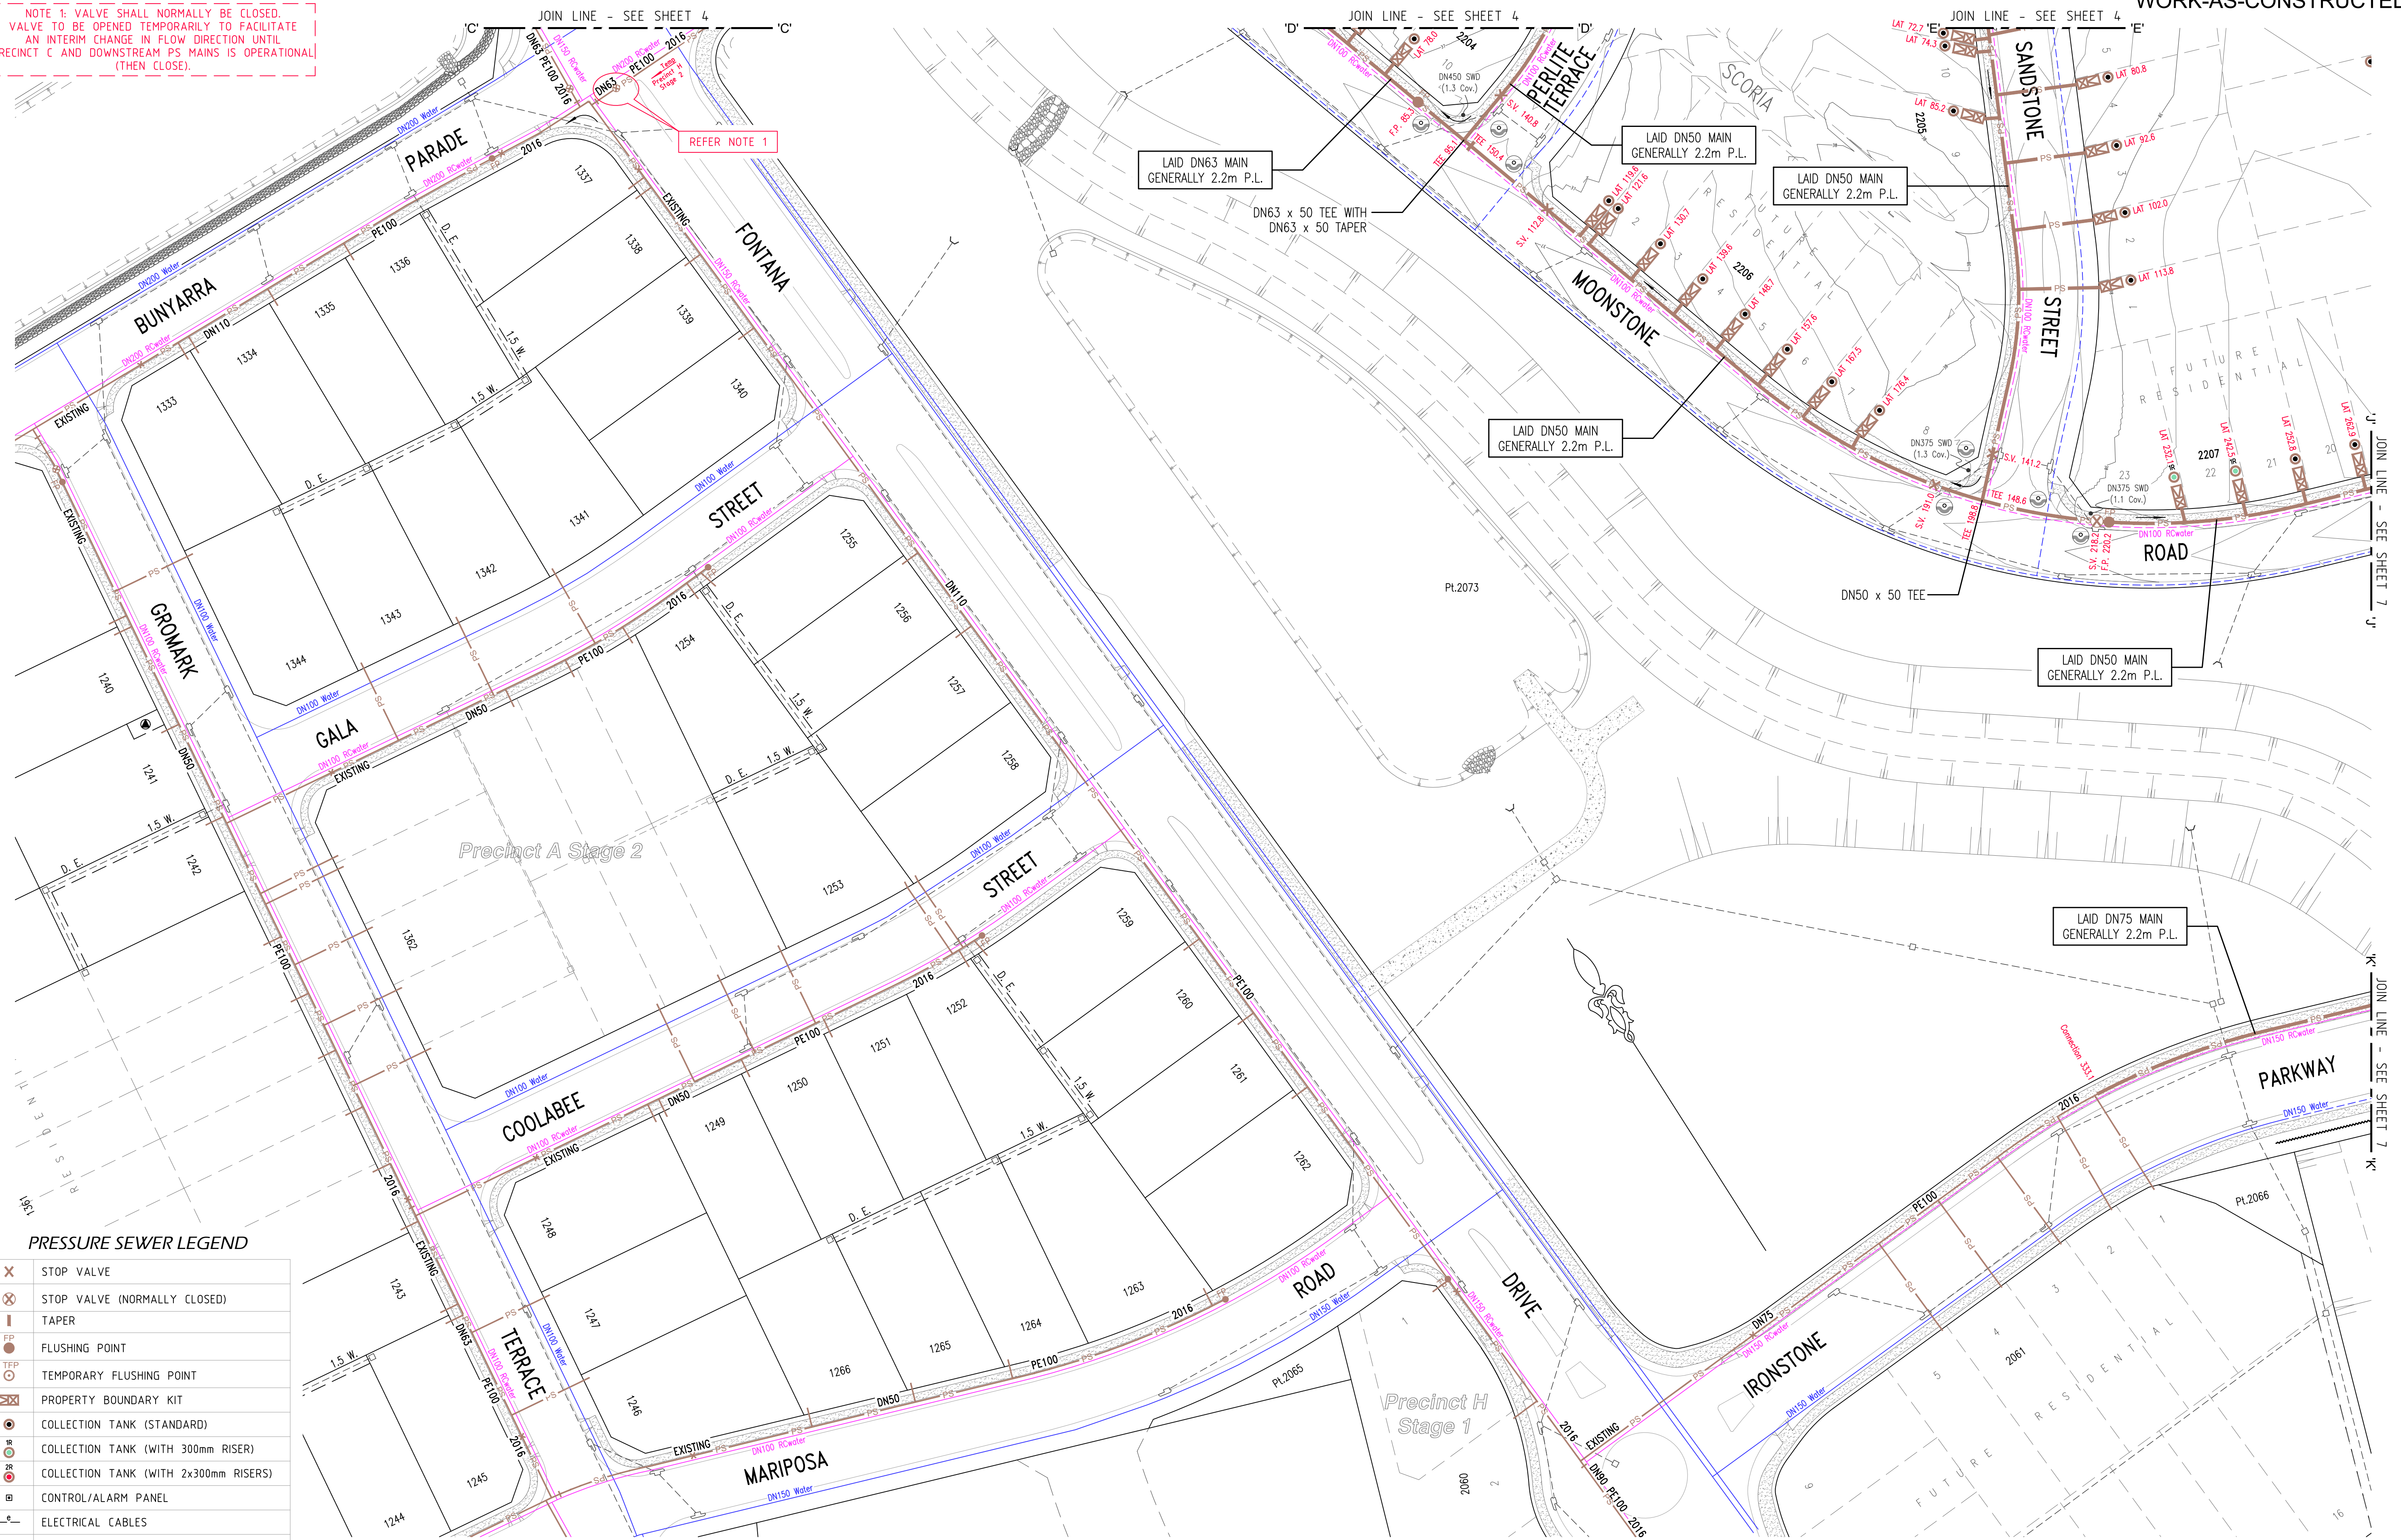


Box Hill Water

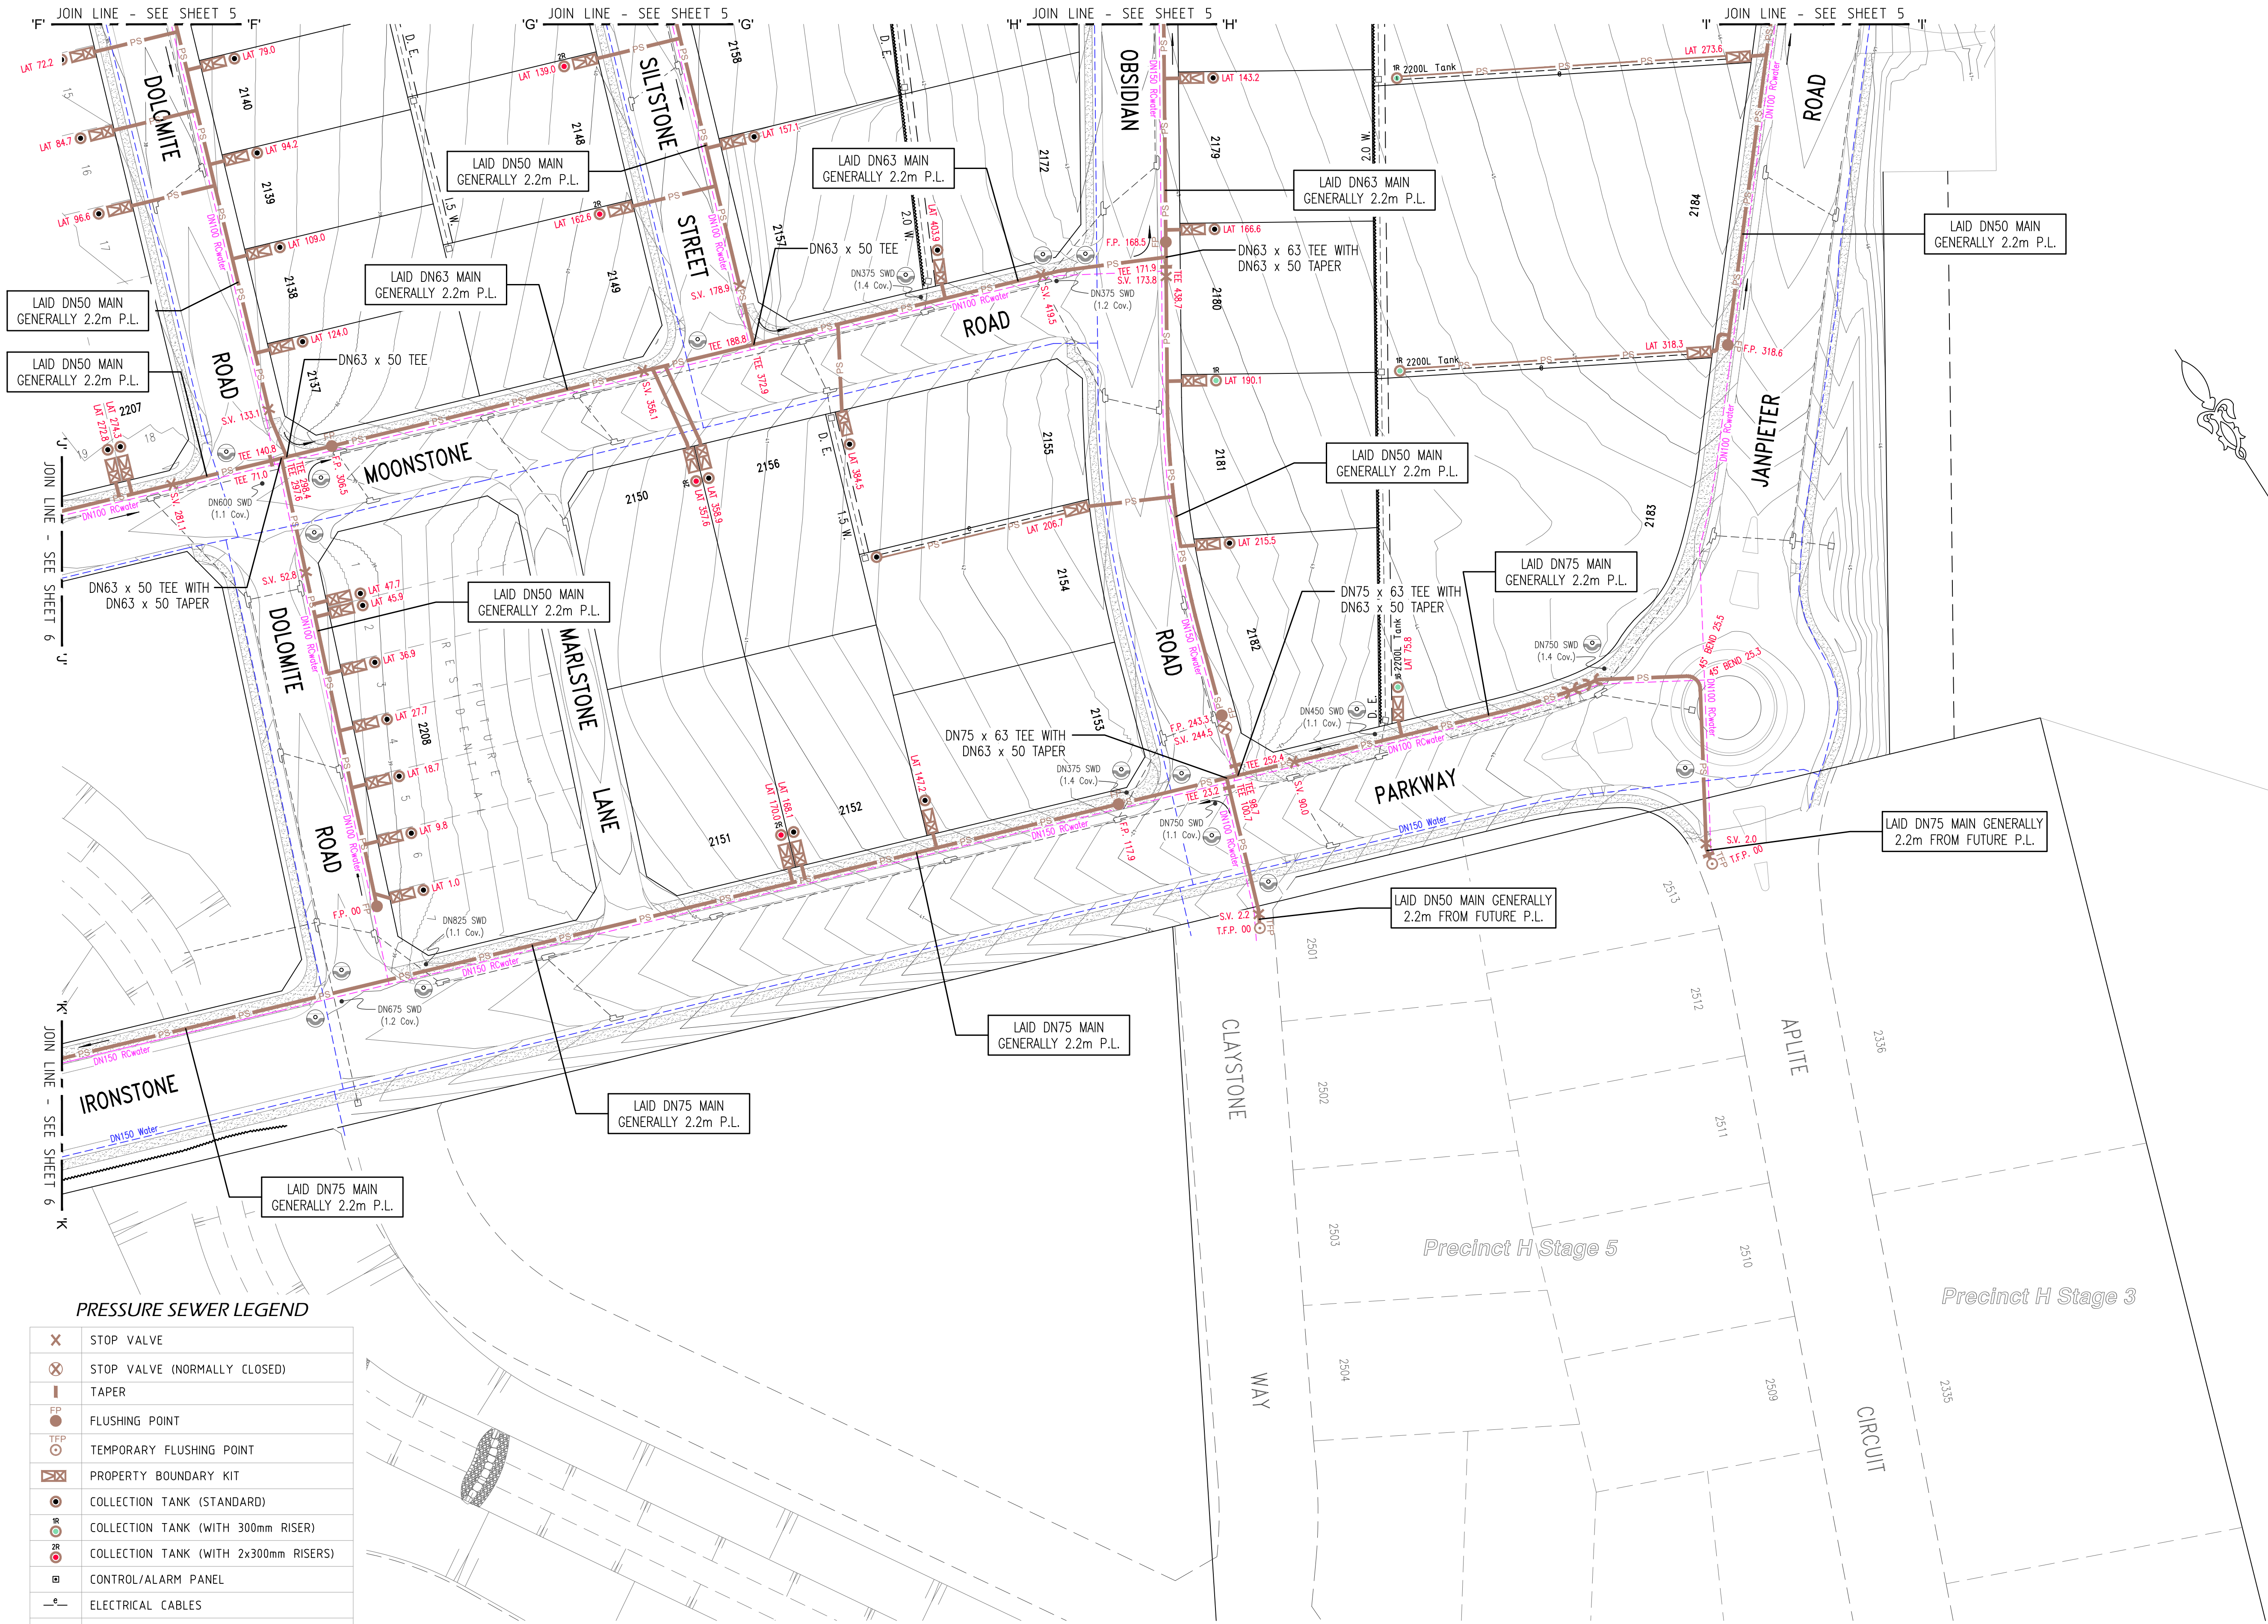

PRESSURE SEWER LEGEND

	STOP VALVE
	STOP VALVE (NORMALLY CLOSED)
	TAPER
	FLUSHING POINT
	TEMPORARY FLUSHING POINT
	PROPERTY BOUNDARY KIT
	COLLECTION TANK (STANDARD)
	COLLECTION TANK (WITH 300mm RISER)
	COLLECTION TANK (WITH 2x300mm RISERS)
	CONTROL/ALARM PANEL
	ELECTRICAL CABLES
	FLOW METER
	AIR VALVE
	PRESSURE MONITORING POINT
	REMOTE MONITORED PRESSURE TRANSDUCER
	VERTICAL DEFLECTION

	DENOTES LAY MAIN UNDER SERVICE
	DENOTES LAY MAIN OVER SERVICE

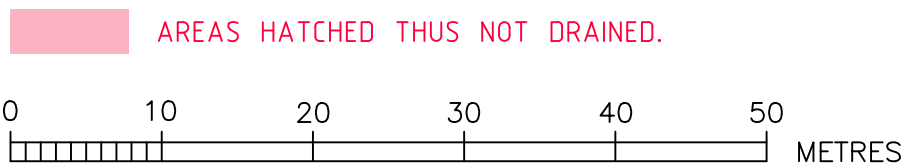


ROSE ATKINS RIMMER (Infrastructure) Pty. Ltd.
WATER RELATED INFRASTRUCTURE DESIGN AND MANAGEMENT
142 SUNNYHOLT ROAD, BLACKTOWN
P.O. BOX 6745, BLACKTOWN N.S.W. 2148
PH: (02) 9853 0200 FAX: (02) 9671 7399



PRESSURE SEWER DETAIL PLAN 4			
DRAWN: K.GAO	DESIGNED: K.GAO	REVIEWED: V.VIKSNE	VERIFIED: D.SHEATHER
SCALE: 1:500	DATAN: A.H.D.	DATA REFERENCE: 108 L2-L3	DATE OF ISSUE: 5/2/2018

SHEET 7 OF 15	VERSION: WAC
4/23645/H2	

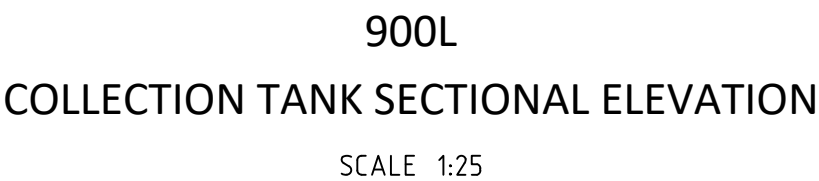

Box Hill + Water

ROSE ATKINS RIMMER (Infrastructure) Pty. Ltd. RAR WATER RELATED INFRASTRUCTURE DESIGN AND MANAGEMENT 162 SUNNYHOLT ROAD, BLACKTOWN P.O. BOX 6745, BLACKTOWN N.S.W. 2148 PH: (02) 9853 0200 FAX: (02) 9671 7399 Incorporated in New South Wales		QUALITY SYSTEM  Quality Endorsed Company	COLLECTION TANK SETOUT DETAILS				SHEET 8 OF 15	VERSION WAC
DRAFTED K.GAO			DESIGNED K.GAO		REVIEWED V.VIKSNE		VERIFIED D.SHEATHER	
SCALE -			DATE -		UAS REFERENCE 108 L2-L3		DATE OF ISSUE 5/2/2018	
						JOB No: 4/23645/H2		

PRESSURE SEWER COLLECTION TANK LEVEL DETAILS								
BOX HILL DEVELOPMENT - PRECINCT H [STAGE 2]								
LOT NUMBER	COLLECTION TANK LOCATION	TANK SIZE	PFSL AT TANK LOCATION	QUANTITY OF DRYWELL RISERS REQUIRED	TOP OF COLLECTION TANK	DESIGN SANITARY DRAINAGE INVERT LEVEL	TOP OF COLLECTION TANK LID *	CALCULATED SANITARY DRAINAGE INVERT LEVEL
	[FRONT / REAR]	[900L / 2200L]			[Design R.L.]	[Design R.L.]	[Work-As-Constructed]	[Work-As-Constructed]
2101	FRONT	900L	36.18		36.20	35.05	36.34	35.00
2102	FRONT	900L	36.23		36.30	35.15	36.39	35.05
2103	FRONT	900L	36.50		36.50	35.35	36.68	35.34
2104	FRONT	900L	36.78		36.80	35.65	36.97	35.63
2105	FRONT	900L	37.05		37.10	35.95	37.26	35.92
2106	FRONT	900L	37.32		37.35	36.20	37.50	36.16
2107	FRONT	900L	38.00	1	38.00	36.55	38.21	36.57
2108	FRONT	900L	37.99	2	37.99	36.24	38.20	36.26
2109	FRONT	900L	37.15		37.20	36.05	37.33	35.99
2110	FRONT	900L	36.89		36.90	35.75	37.09	35.75
2111	FRONT	900L	36.62		36.70	35.55	36.81	35.47
2112	FRONT	900L	36.35		36.38	35.23	36.53	35.19
2113	FRONT	900L	36.08		36.10	34.95	36.28	34.94
2114	FRONT	900L	36.04		36.10	34.95	36.19	34.85
2115	FRONT	900L	35.92		36.00	34.85	36.09	34.75
2116	FRONT	900L	36.69	2	36.69	34.94	37.01	35.07
2117	FRONT	900L	36.74		36.75	35.60	36.97	35.63
2118	FRONT	900L	37.04		37.10	35.95	37.25	35.91
2119	FRONT	900L	37.33		37.38	36.23	37.68	36.34
2120	FRONT	900L	37.65		37.70	36.55	37.92	36.58
2121	FRONT	900L	38.07		38.10	36.95	38.28	36.94
2122	FRONT	900L	38.54		38.58	37.43	38.74	37.40
2123	FRONT	900L	39.02		39.10	37.95	39.26	37.92
2124	FRONT	900L	39.57		39.60	38.45	39.78	38.44
2125	FRONT	900L	39.98	1	39.95	38.50	40.24	38.60
2126	FRONT	900L	39.83	2	39.82	38.07	40.09	38.15
2127	FRONT	900L	38.69		38.72	37.57	38.94	37.60
2128	FRONT	900L	38.39		38.50	37.35	38.62	37.28
2129	FRONT	900L	38.11		38.15	37.00	38.38	37.04
2130	FRONT	900L	37.81		37.85	36.70	38.03	36.69
2131	FRONT	900L	37.53		37.58	36.43	37.75	36.41
2132	FRONT	900L	37.24		37.28	36.13	37.53	36.19
2133	FRONT	900L	36.96		36.98	35.83	37.17	35.83
2134	FRONT	900L	36.68		36.70	35.55	36.92	35.58
2135	FRONT	900L	36.59	1	36.62	35.17	36.93	35.29
2136	FRONT	900L	36.12		36.18	35.03	36.31	34.97
2137	FRONT	900L	38.55		38.60	37.45	38.79	37.45
2138	FRONT	900L	38.43		38.50	37.35	38.67	37.33
2139	FRONT	900L	38.31		38.38	37.23	38.54	37.20
2140	FRONT	900L	38.21		38.30	37.15	38.42	37.08
2141	FRONT	900L	38.10		38.15	37.00	38.30	36.96
2142	FRONT	900L	38.00		38.10	36.95	38.20	36.86
2143	FRONT	900L	37.91		37.95	36.80	38.11	36.77
2144	FRONT	900L	37.89		37.95	36.80	38.07	36.73
2145	FRONT	900L	38.75		38.75	37.60	38.96	37.62
2146	FRONT	900L	39.50	2	39.55	37.80	39.70	37.76
2147	FRONT	900L	39.71	2	39.68	37.93	39.98	38.04
2148	FRONT	900L	39.95	2	39.90	38.15	40.18	38.24
2149	FRONT	900L	40.19	2	40.10	38.35	40.41	38.47
2150	FRONT	900L	40.61	2	40.70	38.95	40.75	38.81
2151	FRONT	900L	40.66	2	40.70	38.95	40.84	38.90
2152	FRONT	900L	40.73		40.75	39.60	40.91	39.57
2153	FRONT	900L	41.36		41.36	40.21	41.54	40.20
2154	REAR	900L	41.58		41.66	40.51	41.79	40.45
2155	FRONT	900L	41.40		41.40	40.25	41.56	40.22
2156	FRONT	900L	40.69		40.70	39.55	40.88	39.54
2157	FRONT	900L	40.39		40.60	39.45	40.54	39.20
2158	FRONT	900L	39.97		40.05	38.90	40.13	38.79
2159	FRONT	900L	39.76		39.85	38.70	40.02	38.68
2160	FRONT	900L	39.60		39.70	38.55	39.83	38.49
2161	FRONT	900L	39.64		39.70	38.55	39.84	38.50
2162	FRONT	900L	39.83		39.90	38.75	40.04	38.70
2163	FRONT	900L	40.01		40.10	38.95	40.20	38.86
2164	FRONT	900L	40.19		40.10	38.95	40.34	39.00
2165	FRONT	900L	42.68		42.68	41.53	42.84	41.50
2166	REAR	900L	42.64		42.72	41.57	42.80	41.46
2167	REAR	900L	42.52		42.60	41.45	42.73	41.39
2168	REAR	900L	42.36		42.44	41.29	42.52	41.18
2169	REAR	900L	42.26		42.34	41.19	42.40	41.06
2170	REAR	900L	42.17	1	42.25	40.80	42.36	40.72
2171	REAR	900L	42.06	1	42.14	40.69	42.26	40.62
2172	FRONT	900L	41.99		41.99	40.84	42.23	40.89
2173	FRONT	900L	44.33		44.35	43.20	44.50	43.16
2174	FRONT	900L	44.31		44.35	43.20	44.50	43.16
2175	FRONT	900L	44.10		44.13	42.98	44.33	42.99
2176	FRONT	900L	43.89		43.92	42.77	44.06	42.72
2177	FRONT	900L	43.69		43.73	42.58	43.88	42.54
2178	FRONT	900L	43.47		43.50	42.35	43.64	42.30
2179	FRONT	900L	43.24		43.30	42.15	43.40	42.06
2180	FRONT	900L	43.01		43.10	41.95	43.17	41.83
2181	FRONT	900L	42.77	1	42.80	41.35	42.96	41.32
2182	FRONT	900L	42.51		42.55	41.40	42.67	41.33
2183	FRONT	2200L	43.72	1	43.78	42.49	43.87	42.39
2184	REAR	2200L	44.37	1	44.45	43.16	44.57	43.09
2185	REAR	2200L	44.73		44.81	43.82	44.91	43.73
2186	REAR	2200L	45.04	1	45.12	43.83	45.27	43.79
2187	REAR	2200L	45.32	1	45.40	44.11	45.51	44.03
2188	FRONT	2200L	44.83	1	44.83	43.54	44.87	43.39
2189	FRONT	2200L	45.03	1	45.03	43.74	45.21	43.73
2190	REAR	2200L	46.88	1	46.96	45.67	47.09	45.61

* COLLECTION TANK LEVEL PROVIDED TO G.P.S. ACCURACY ONLY. THE BUILDER IS REQUIRED TO CONFIRM DRAINAGE CONSTRAINTS PRIOR TO MAKING CONNECTION TO TANK.

COLLECTION TANK NOTES

1. DESIGN SURFACE LEVELS WERE ELECTRONICALLY EXTRACTED FROM DIGITAL DATA SUPPLIED BY J. WYNDHAM PRINCE CONSULTING CIVIL INFRASTRUCTURE ENGINEERS & PROJECT MANAGERS 28/2/17 (170228 Precinct H CC Design Stage 1 and 2.12daz).
2. DESIGN LEVELS CAN ONLY BE ASSUMED AS CURRENT AT TIME OF EXTRACTION. ALL LEVELS SHALL BE CONFIRMED WITH THE SITE SUPERINTENDENT *PRIOR* TO INSTALLATION OF TANKS. SHOULD THE PROPOSED FINISHED SURFACE LEVEL (P.F.S.L.) DIFFER FROM DESIGN BY MORE THAN 100mm, THE CONSTRUCTOR SHALL CONTACT THE DESIGNER IMMEDIATELY.
3. COLLECTION TANK SETOUT SHALL BE COMPLIANT WITH *FSI-1000-FS* & *FSI-SK03A-FS*. COLLECTION TANK INSTALLATION LEVELS DOCUMENTED ADJACENT SHALL SUPERSEDE ANY LEVELS ADVISED ON DRAWING FSI-SK03A-FS.
4. R.A.R. ACCEPT NO RESPONSIBILITY FOR INCONSISTENCIES IN EXTRACTED LEVELS RESULTING FROM CHANGES TO THE MODEL (SURFACE LEVEL) INFORMATION POST DATA EXTRACTION DATE.

PRESSURE SEWER COLLECTION TANK LEVEL DETAILS								
BOX HILL DEVELOPMENT - PRECINCT H [STAGE 2]								
LOT NUMBER	COLLECTION TANK LOCATION	TANK SIZE	PFSL AT TANK LOCATION	QUANTITY OF DRYWELL RISERS REQUIRED	TOP OF COLLECTION TANK	DESIGN SANITARY DRAINAGE INVERT LEVEL	TOP OF COLLECTION TANK LID *	CALCULATED SANITARY DRAINAGE INVERT LEVEL
	[FRONT / REAR]	[900L / 2200L]			[Design R.L.]	[Design R.L.]	[Work-As-Constructed]	[Work-As-Constructed]
2191	REAR	2200L	48.04	1	48.12	46.83	48.20	46.72
2192	FRONT	900L	46.09		46.10	44.95	46.24	44.90
2193	FRONT	900L	45.40		45.45	44.30	45.54	44.20
2194	FRONT	900L	45.33	1	45.40	43.95	45.49	43.85
2195	FRONT	900L	44.67		44.80	43.65	44.85	43.51
2196	FRONT	900L	45.04	2	45.04	43.29	45.25	43.31
2197	FRONT	900L	43.56		43.60	42.45	43.73	42.39
2198	FRONT	900L	42.25		42.30	41.15	42.41	41.07
2199	FRONT	900L	41.06		41.10	39.95	41.24	39.90
2200	FRONT	900L	40.31		40.35	39.20	40.44	39.10
2201	FRONT	900L	39.77		39.80	38.65	39.93	38.59
2202(1)	FRONT	900L	35.48		35.50	34.35	35.61	34.27
2202(2)	FRONT	900L	35.48		35.50	34.35	35.66	34.32
2202(3)	FRONT	900L	35.37		35.40	34.25	35.54	34.20
2202(4)	FRONT	900L	35.35		35.40	34.25	35.48	34.14
2202(5)	FRONT	900L	35.26		35.30	34.15	35.42	34.08
2202(6)	FRONT	900L	35.25		35.30	34.15	35.43	34.09
2203(11)	FRONT	900L	36.81		36.85	35.70	36.94	35.60
2203(12)	FRONT	900L	36.67		36.70	35.55	36.79	35.45
2203(13)	FRONT	900L	36.52		36.53	35.38	36.66	35.32
2203(14)	FRONT	900L	36.37		36.38	35.23	36.48	35.14
2203(15)	FRONT	900L	36.25		36.30	35.15	36.37	35.03
2203(16)	FRONT	900L	36.09		36.10	34.95	36.25	34.91
2203(17)	FRONT	900L	35.97		35.97	34.82	36.09	34.75
2203(18)	FRONT	900L	35.81		35.80	34.65	35.93	34.59
2203(19)	FRONT	900L	35.78	1	35.78	34.33	35.92	34.28
2203(20)	FRONT	900L	35.51		35.55	34.40	35.69	34.35
2203(21)	FRONT	900L	35.58		35.62	34.47	35.73	34.39
2203(22)	FRONT	900L	35.69		35.70	34.55	35.86	34.52
2203(23)	FRONT	900L	35.76		35.80	34.65	35.90	34.56
2203(24)	FRONT	900L	35.86		35.90	34.75	36.00	34.66
2203(25)	FRONT	900L	35.94		36.00	34.85	36.07	34.73
2204(1)	FRONT	900L	36.15		36.16	35.01	36.30	34.96
2204(2)	FRONT	900L	36.17		36.18	35.03	36.31	34.97
2204(3)	FRONT	900L	36.25		36.30	35.15	36.37	35.03
2204(4)	FRONT	900L	36.34		36.38	35.23	36.50	35.16
2204(5)	FRONT	900L	36.42		36.45	35.30	36.60	35.26
2204(6)	FRONT	900L	36.50		36.53	35.38	36.65	35.31
2204(7)	FRONT	900L	36.57		36.63	35.48	36.70	35.36
2204(8)	FRONT	900L	36.65		36.70	35.55	36.81	35.47
2204(9)	FRONT	900L	36.76		36.90	35.75	36.92	35.58
2204(10)	FRONT	900L	36.92		37.00	35.85	37.06	35.72
2205(9)	FRONT	900L	37.74		37.80	36.65	37.90	36.56
2205(10)	FRONT	900L	37.55		37.58	36.43	37.76	36.42
2205(11)	FRONT	900L	37.50		37.55	36.40	37.70	36.36
2205(12)	FRONT	900L	37.32		37.35	36.20	37.51	36.17
2205(13)	FRONT	900L	37.14		37.20	36.05	37.34	36.00
2205(14)	FRONT	900L	36.68		36.75	35.60	36.85	35.51
2205(15)	FRONT	900L	36.69		36.75	35.60	36.87	35.53
2205(16)	FRONT	900L	36.53		36.60	35.45	36.69	35.35
2205(17)	FRONT	900L	36.38		36.50	35.35	36.54	35.20
2205(18)	FRONT	900L	37.13		37.15	36.00	37.31	35.97
2205(19)	FRONT	900L	37.13		37.15	36.00	37.32	35.98
2206(1)	FRONT	900L	37.14		37.14	35.99	37.31	35.97
2206(2)	FRONT	900L	37.16		37.16	36.01	37.34	36.00
2206(3)	FRONT	900L	37.31		37.35	36.20	37.52	36.18
2206(4)	FRONT	900L	37.41		37.50	36.35	37.59	36.25
2206(5)	FRONT	900L	37.50		37.55	36.40	37.67	36.33
2206(6)	FRONT	900L	37.59		37.62	36.47	37.74	36.40
2206(7)	FRONT	900L	37.69		37.73	36.58	37.86	36.52
2206(8)	FRONT	900L	37.86		37.90	36.75	38.02	36.68
2207(1)	FRONT	900L	38.05		38.00	36.90	38.19	36.85
2207(2)	FRONT	900L	37.98		38.00	36.85	38.20	36.86
2207(3)	FRONT	900L	37.86		37.90	36.75	38.04	36.70
2207(4)	FRONT	900L	37.68		37.70	36.55	37.90	36.56
2207(5)	FRONT	900L	37.52		37.58	36.43	37.68	36.34
2207(6)	FRONT	900L	37.34		37.39	36.24	37.54	36.20
2207(7)	FRONT	900L	37.12		37.20	36.05	37.30	35.96
2207(8)	FRONT	900L	37.23		37.23	36.08	37.46	36.12
2207(9)	FRONT	900L	37.54		37.60	36.45	37.74	36.40
2207(10)	FRONT	900L	37.76		37.76	36.61	37.95	36.61
2207(11)	FRONT	900L	37.78		37.78	36.63	38.01	36.67
2207(12)	FRONT	900L	37.87		37.90	36.75	38.06	36.72
2207(13)	FRONT	900L	37.95		37.95	36.80	38.13	36.79
2207(14)	FRONT	900L	38.04		38.06	36.91	38.22	36.88
2207(15)	FRONT	900L	38.13		38.15	37.00	38.34	37.00
2207(16)	FRONT	900L	38.22		38.25	37.10	38.46	37.12
2207(17)	FRONT	900L	38.31		38.33	37.18	38.52	37.18
2207(18)	FRONT	900L	38.71		38.73	37.58	38.94	37.60
2207(19)	FRONT	900L	38.68		38.70	37.55	38.88	37.54
2207(20)	FRONT	900L	38.63		38.63	37.48	38.81	37.47
2207(21)	FRONT	900L	38.53		38.53	37.38	38.76	37.42
2207(22)	FRONT	900L	38.42	1	38.42	36.97	38.63	36.99
2207(23)	FRONT	900L	38.29	1	38.27	36.82	38.52	36.88
2208(1)	FRONT	900L	38.71		38.80	37.65	38.91	37.57
2208(2)	FRONT	900L	38.71		38.80	37.65	38.91	37.57
2208(3)	FRONT	900L	38.77		38.85	37.70	38.97	37.63
2208(4)	FRONT	900L	38.83		38.85	37.70	39.02	37.68
2208(5)	FRONT	900L	38.89		39.00	37.85	39.06	37.72
2208(6)	FRONT	900L	38.95		39.05	37.90	39.14	37.80
2208(7)	FRONT	900L	39.02		39.05	37.90	39.23	37.89

* COLLECTION TANK LEVEL PROVIDED TO G.P.S. ACCURACY ONLY. THE BUILDER IS REQUIRED TO CONFIRM DRAINAGE CONSTRAINTS PRIOR TO MAKING CONNECTION TO TANK.

COLLECTION TANK NOTES

1. DESIGN SURFACE LEVELS WERE ELECTRONICALLY EXTRACTED FROM DIGITAL DATA SUPPLIED BY J. WYNDHAM PRINCE CONSULTING CIVIL INFRASTRUCTURE ENGINEERS & PROJECT MANAGERS 28/2/17 (170228 Precinct H CC Design Stage 1 and 2.12da2).
2. DESIGN LEVELS CAN ONLY BE ASSUMED AS CURRENT AT TIME OF EXTRACTION. ALL LEVELS SHALL BE CONFIRMED WITH THE SITE SUPERINTENDENT *PRIOR* TO INSTALLATION OF TANKS. SHOULD THE PROPOSED FINISHED SURFACE LEVEL (P.F.S.L.) DIFFER FROM DESIGN BY MORE THAN 100mm, THE CONSTRUCTOR SHALL CONTACT THE DESIGNER IMMEDIATELY.
3. COLLECTION TANK SETOUT SHALL BE COMPLIANT WITH *FSI-1000-FS* & *FSI-SK03A-FS*. COLLECTION TANK INSTALLATION LEVELS DOCUMENTED ADJACENT SHALL SUPERSEDE ANY LEVELS ADVISED ON DRAWING FSI-SK03A-FS.
4. R.A.R. ACCEPT NO RESPONSIBILITY FOR INCONSISTENCIES IN EXTRACTED LEVELS RESULTING FROM CHANGES TO THE MODEL (SURFACE LEVEL) INFORMATION POST DATA EXTRACTION DATE.

ROSE ATKINS RIMMER (Infrastructure) Pty. Ltd.

RAR

WATER RELATED INFRASTRUCTURE DESIGN AND MANAGEMENT

Incorporated in New South Wales

142 SUNNYHOLT ROAD, BLACKTOWN
P.O. BOX 6745, BLACKTOWN N.S.W. 2148
PH: (02) 9853 0200 FAX: (02) 9671 7399

Quality
Endorsed
Company


COLLECTION TANK LEVEL DETAILS 2				SHEET 10 OF 15	VERSION WAC
DRAWN: K.GAO	DESIGNED: K.GAO	REVIEWED: V.VIKSNE	VERIFIED: D.SHEATHER	JOB No. 4/23645/H2	
SCALE: -	DATAN: -	DATA REFERENCE: 108 L2-L3	DATE OF ISSUE: 5/2/2018		

Precinct H Development Stages

- Stage 1
- Stage 2
- Stage 3
- Stage 4

RECYCLED WATER PIPE SCHEDULE


SIZE	TYPE	CLASS	LENGTH
DN200	PE100	PN16	402.7
DN200	m.P.V.C.	PN16	258.3
DN150	m.P.V.C.	PN16	614.0
DN100	m.P.V.C.	PN16	2,480.6
TOTAL			3,755.6

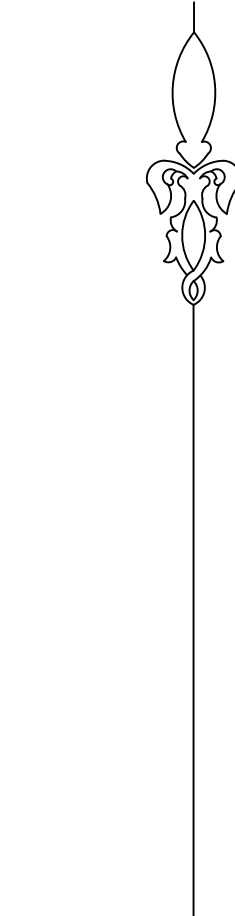

RECYCLED WATER LEGEND


	PROPOSED MAIN (PRESSURE ZONE 1)
	PROPOSED PE100 MAIN (PRESSURE ZONE 2)
	PROPOSED MAIN (PRESSURE ZONE 2)
	EXISTING MAIN
	FUTURE MAIN
	STOP VALVE
	STOP VALVE (NORMALLY CLOSED)
	STOP VALVE (BYPASS)
	REFLUX VALVE
	HYDRANT
	CONTROL VALVE (HYDRANT)
	TAPER
	WATER SERVICE CONNECTION
	FLOW METER
	AIR VALVE
	VERTICAL DEFLECTION
	REMOTE MONITORED PRESSURE TRANSDUCER

WORK-AS-CONSTRUCTED

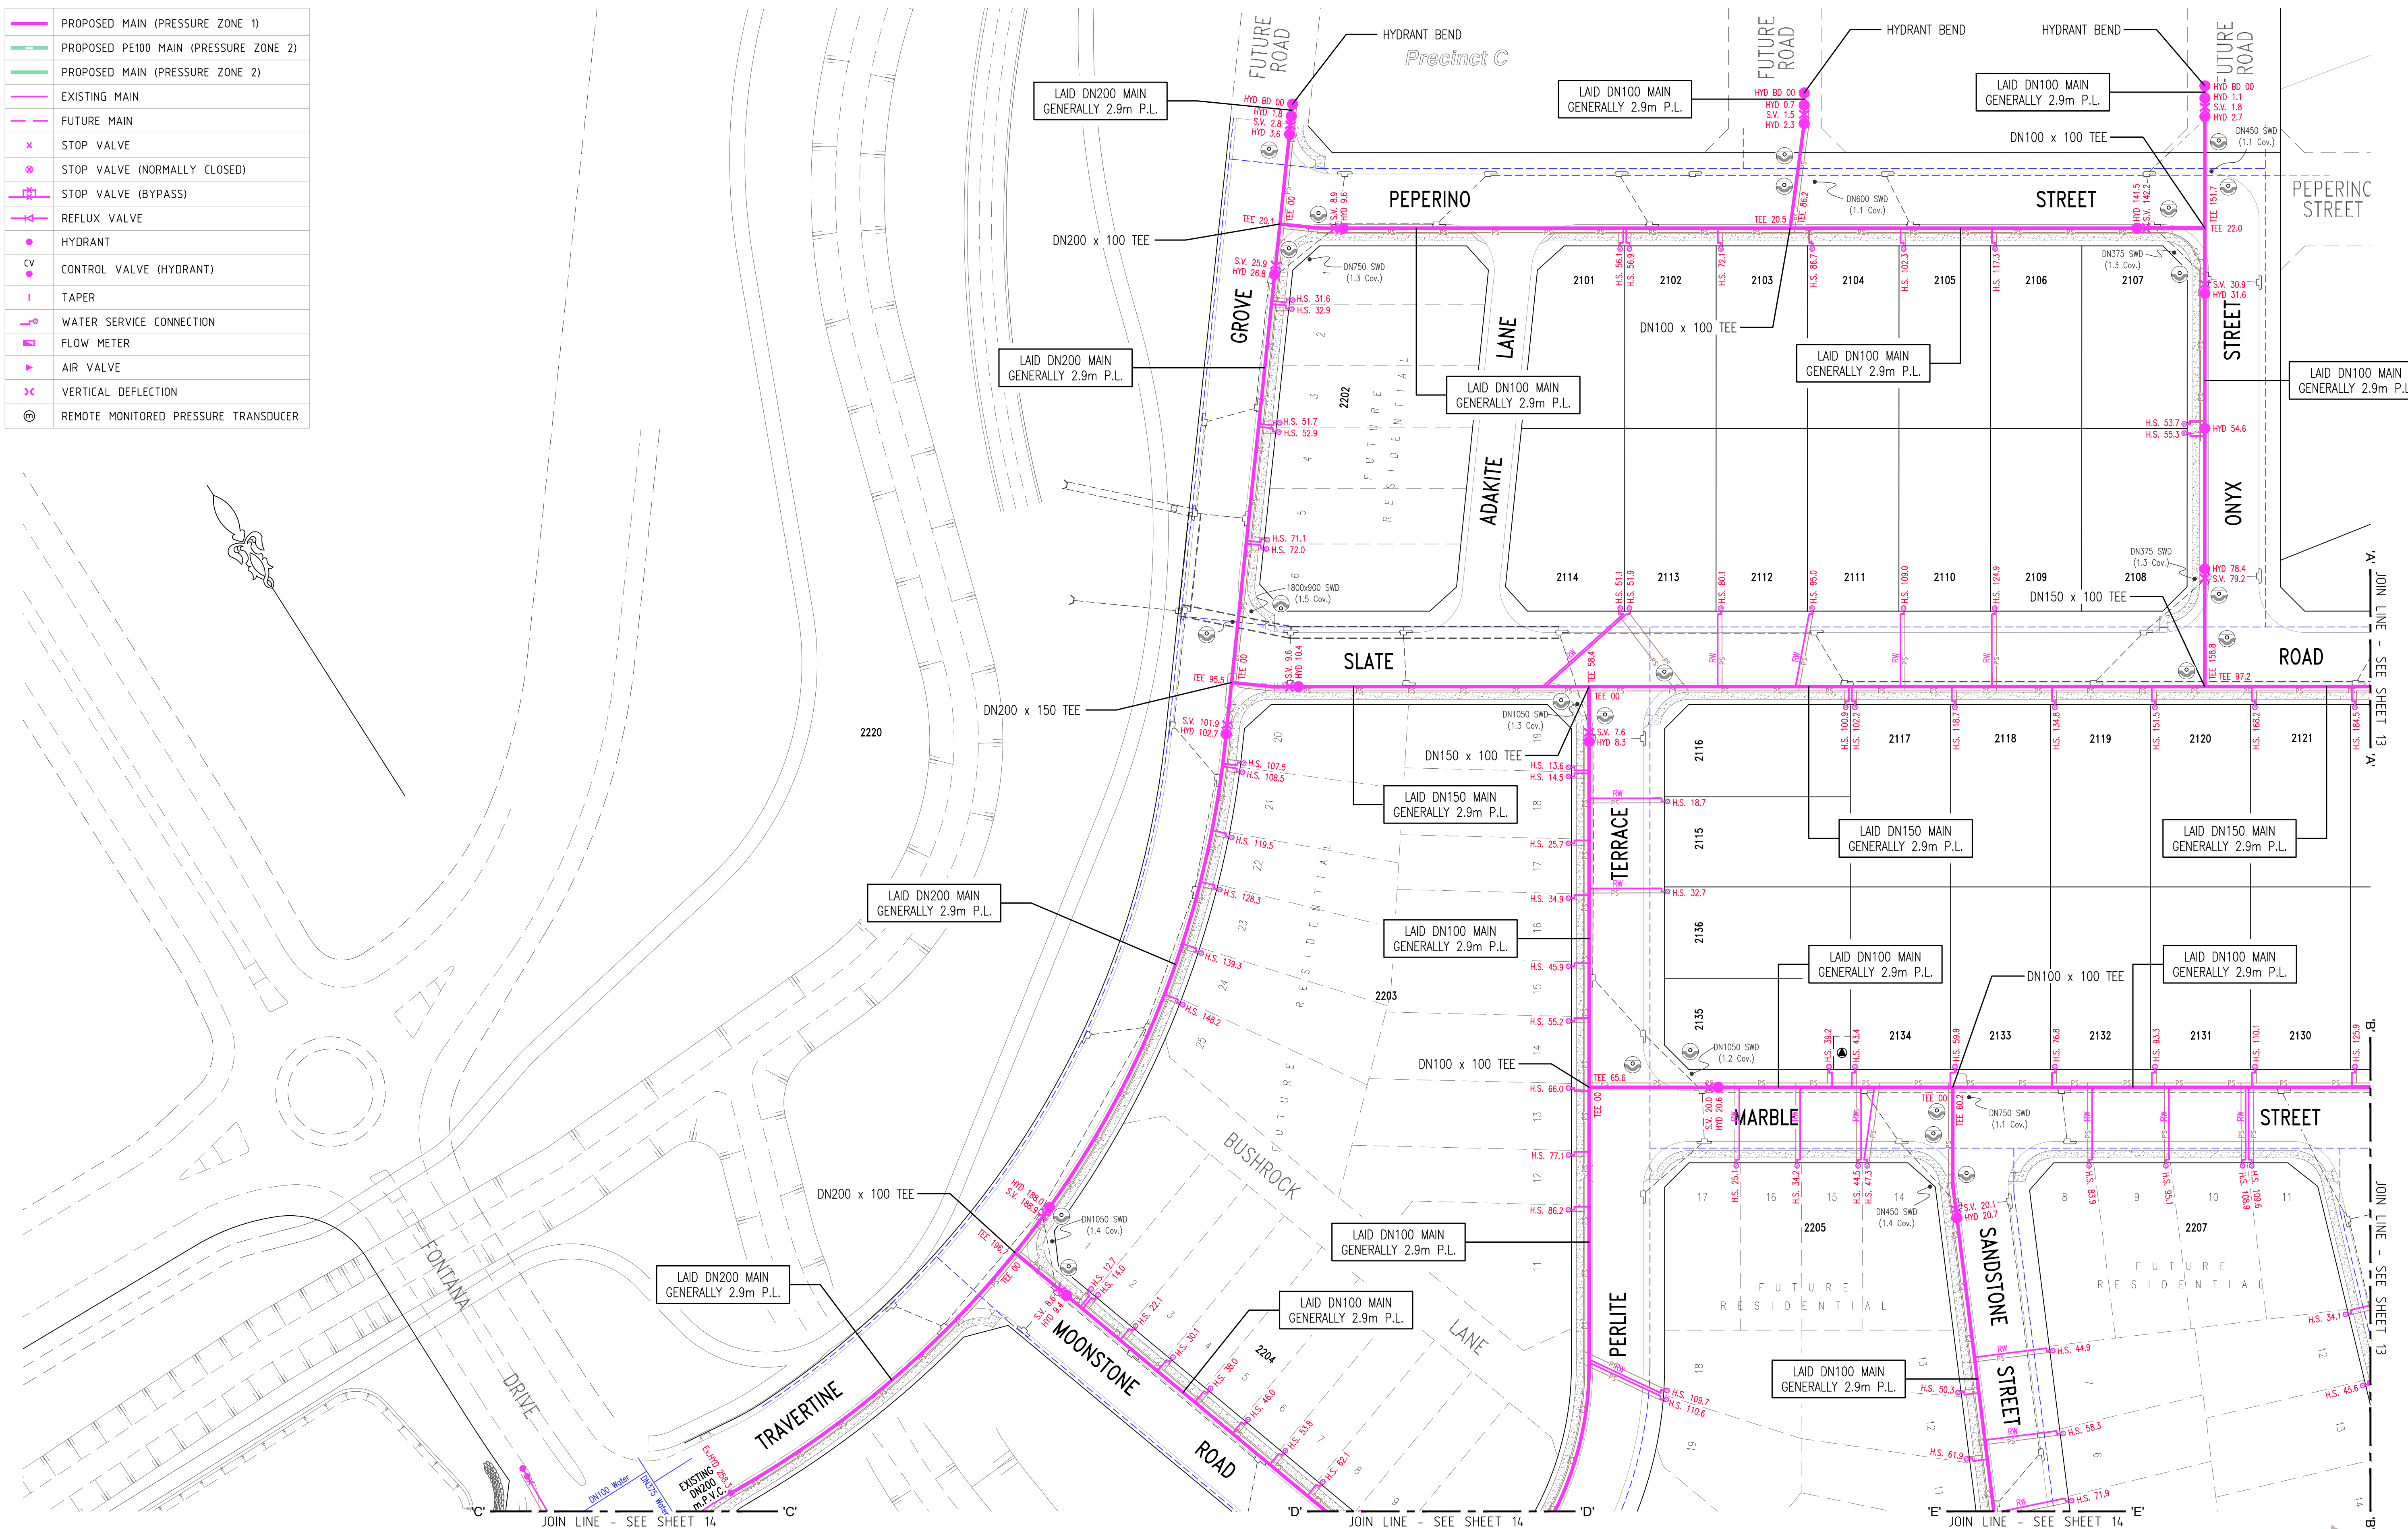

⊙ DENOTES LAY MAIN UNDER SERVICE
⊙ DENOTES LAY MAIN OVER SERVICE

⊙ ESMT FOR PADMOUNT SUBSTATION 2.75 W.

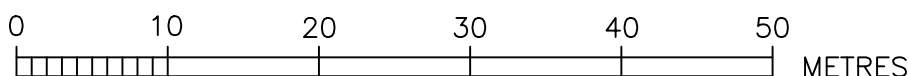


ROSE ATKINS RIMMER (Infrastructure) Pty. Ltd.
RAR WATER RELATED INFRASTRUCTURE DESIGN AND MANAGEMENT
142 SUNNYHOLT ROAD, BLACKTOWN
P.O. BOX 6745, BLACKTOWN N.S.W. 2148
PH: (02) 9853 0200 FAX: (02) 9671 7399




RECYCLED WATER DETAIL PLAN 1			
DRAWN: K.GAO	DESIGNED: K.GAO	REVIEWED: V.VIKSNE	VERIFIED: D.SHEATHER
SCALE: 1:500	DATAN: -	DATA REFERENCE: 108 L2-L3	DATE OF ISSUE: 5/2/2018

SHEET 12 OF 15
4/23645/H2

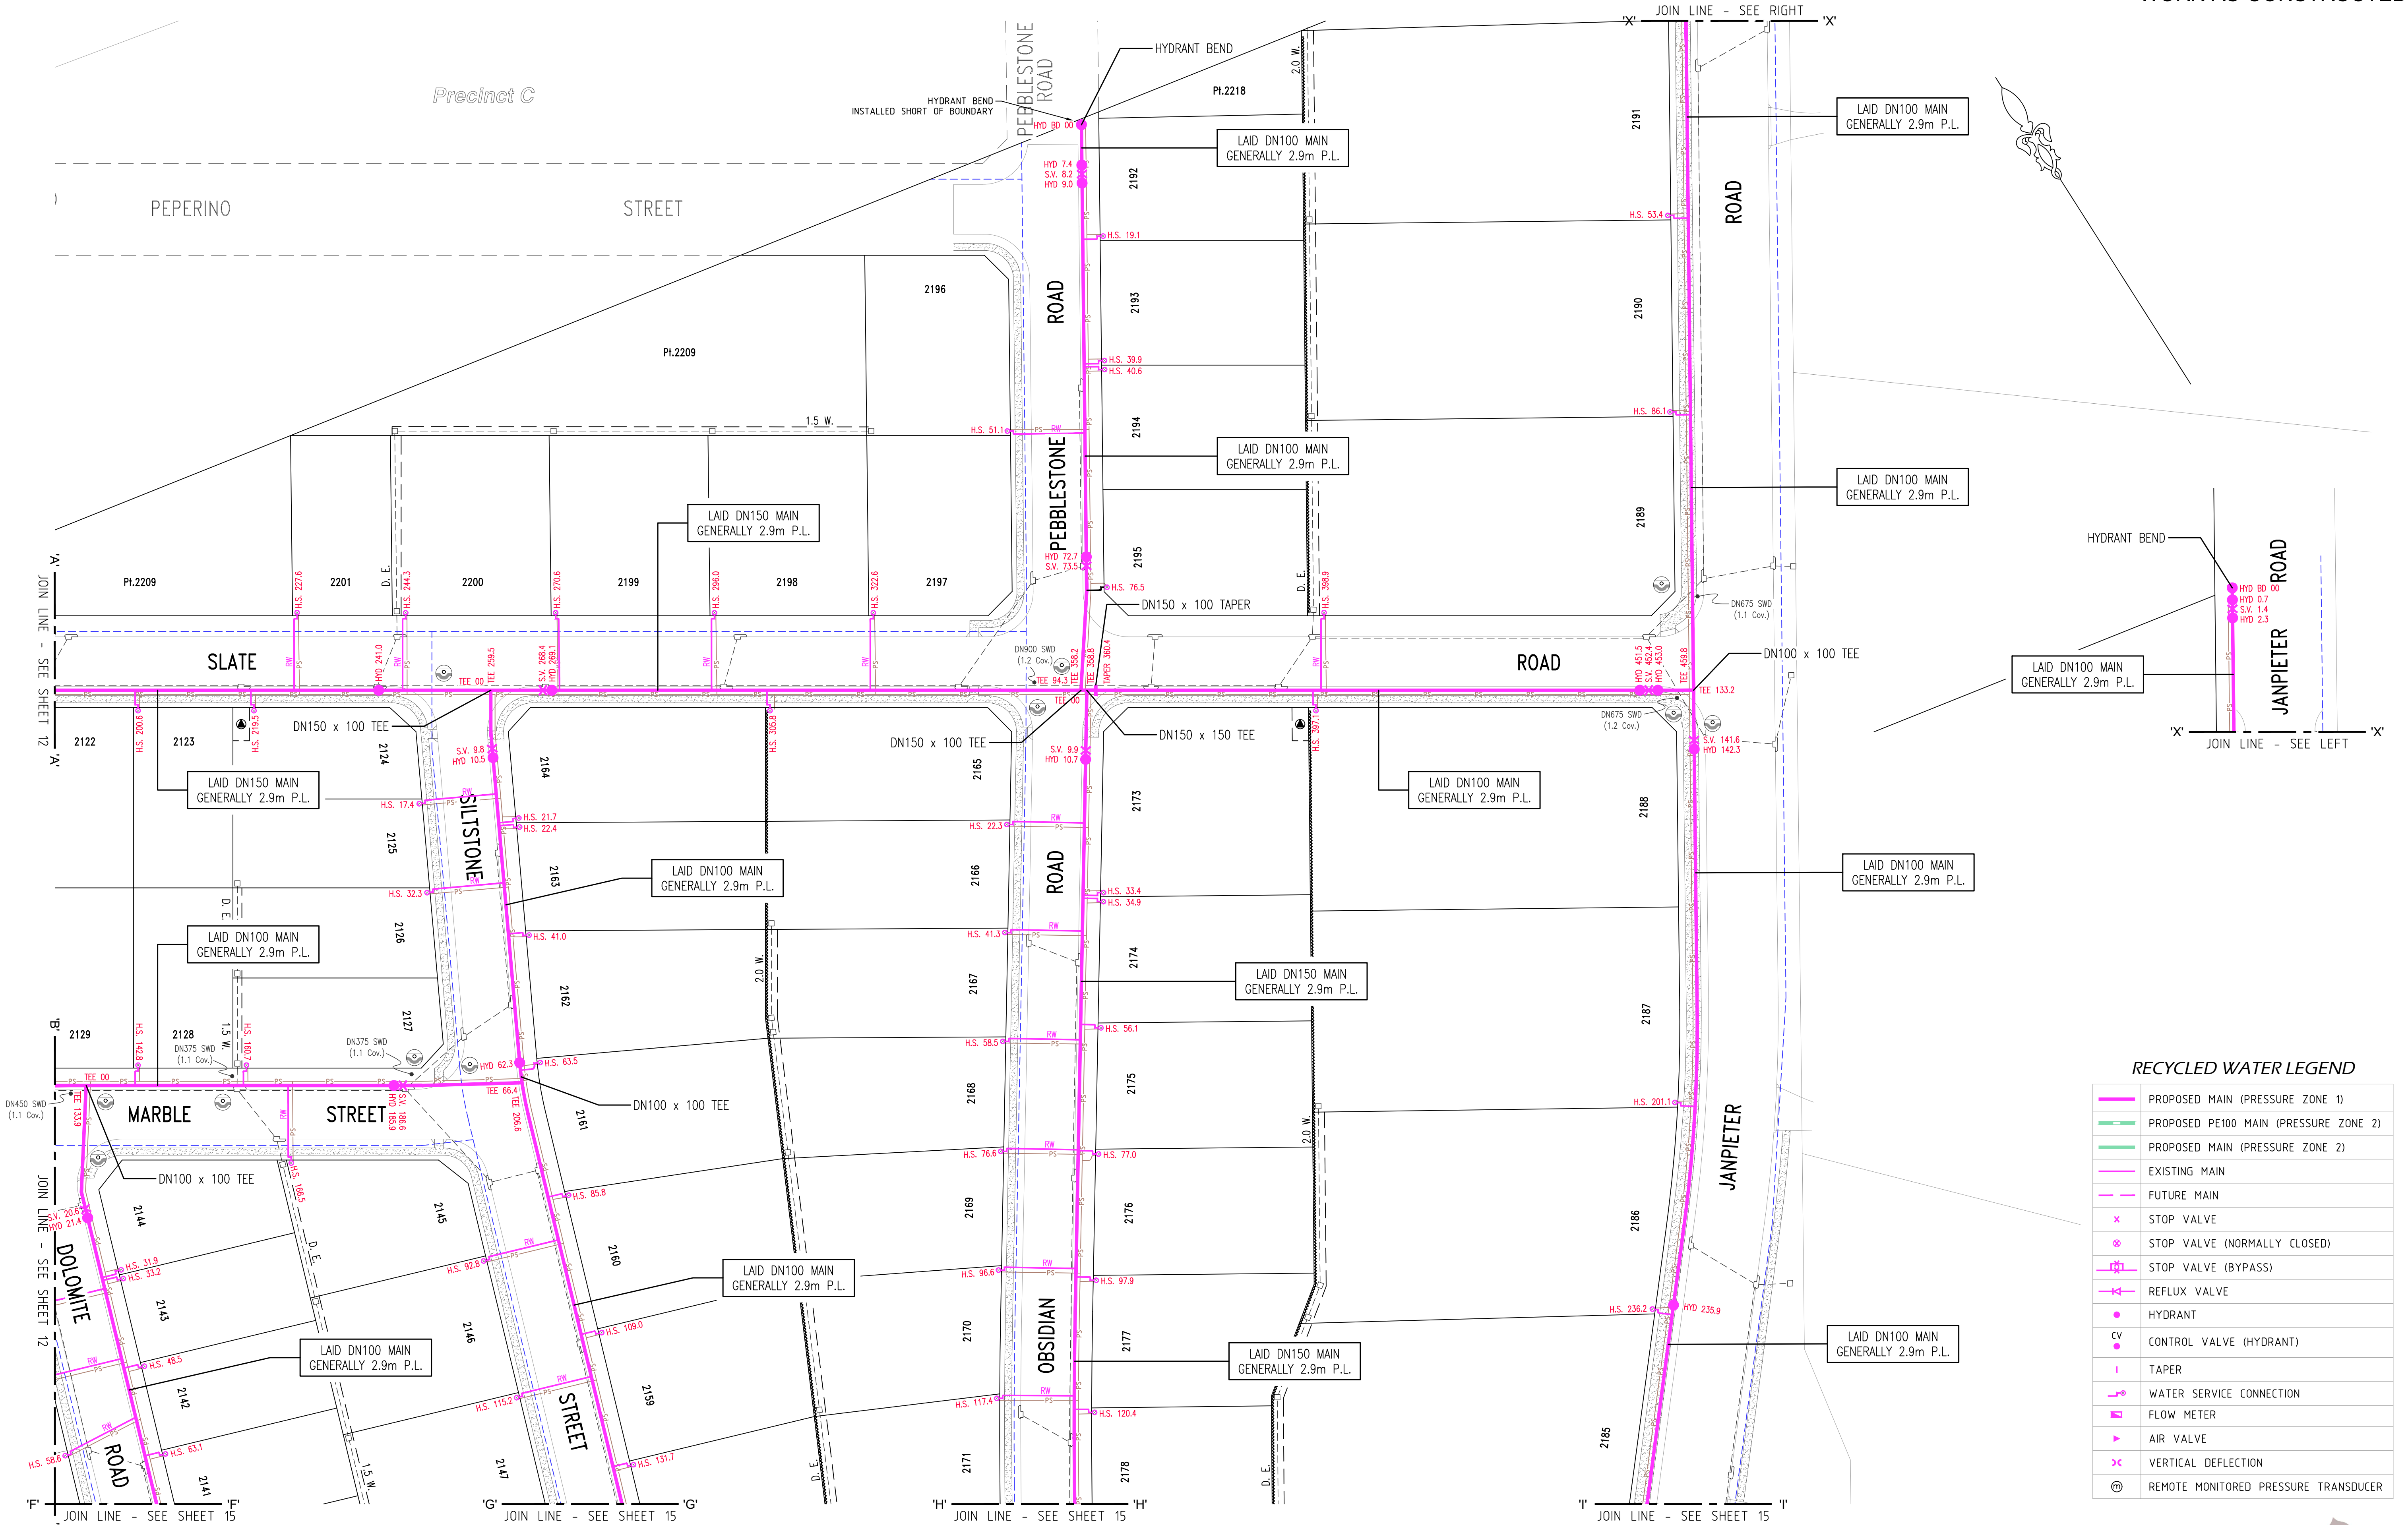

⊙ DENOTES LAY MAIN UNDER SERVICE
⊙ DENOTES LAY MAIN OVER SERVICE

⊙ ESMT FOR PADMOUNT SUBSTATION 2.75 W.

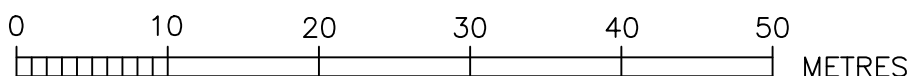

ROSE ATKINS RIMMER (Infrastructure) Pty. Ltd.
WATER RELATED INFRASTRUCTURE DESIGN AND MANAGEMENT
142 SUNNYHOLT ROAD, BLACKTOWN
P.O. BOX 6745, BLACKTOWN N.S.W. 2148
PH: (02) 9853 0200 FAX: (02) 9671 7399




RECYCLED WATER DETAIL PLAN 2


DESIGNED	K.GAO	REVIEWED	V.VIKSNE	VERIFIED	D.SHEATHER
SCALE	1:500	DATE	-	DATE OF ISSUE	5/2/2018
DATA	-	DATA REFERENCE	108 L2-L3	DATE OF ISSUE	5/2/2018

SHEET 13 OF 15

WAC

4/23645/H2

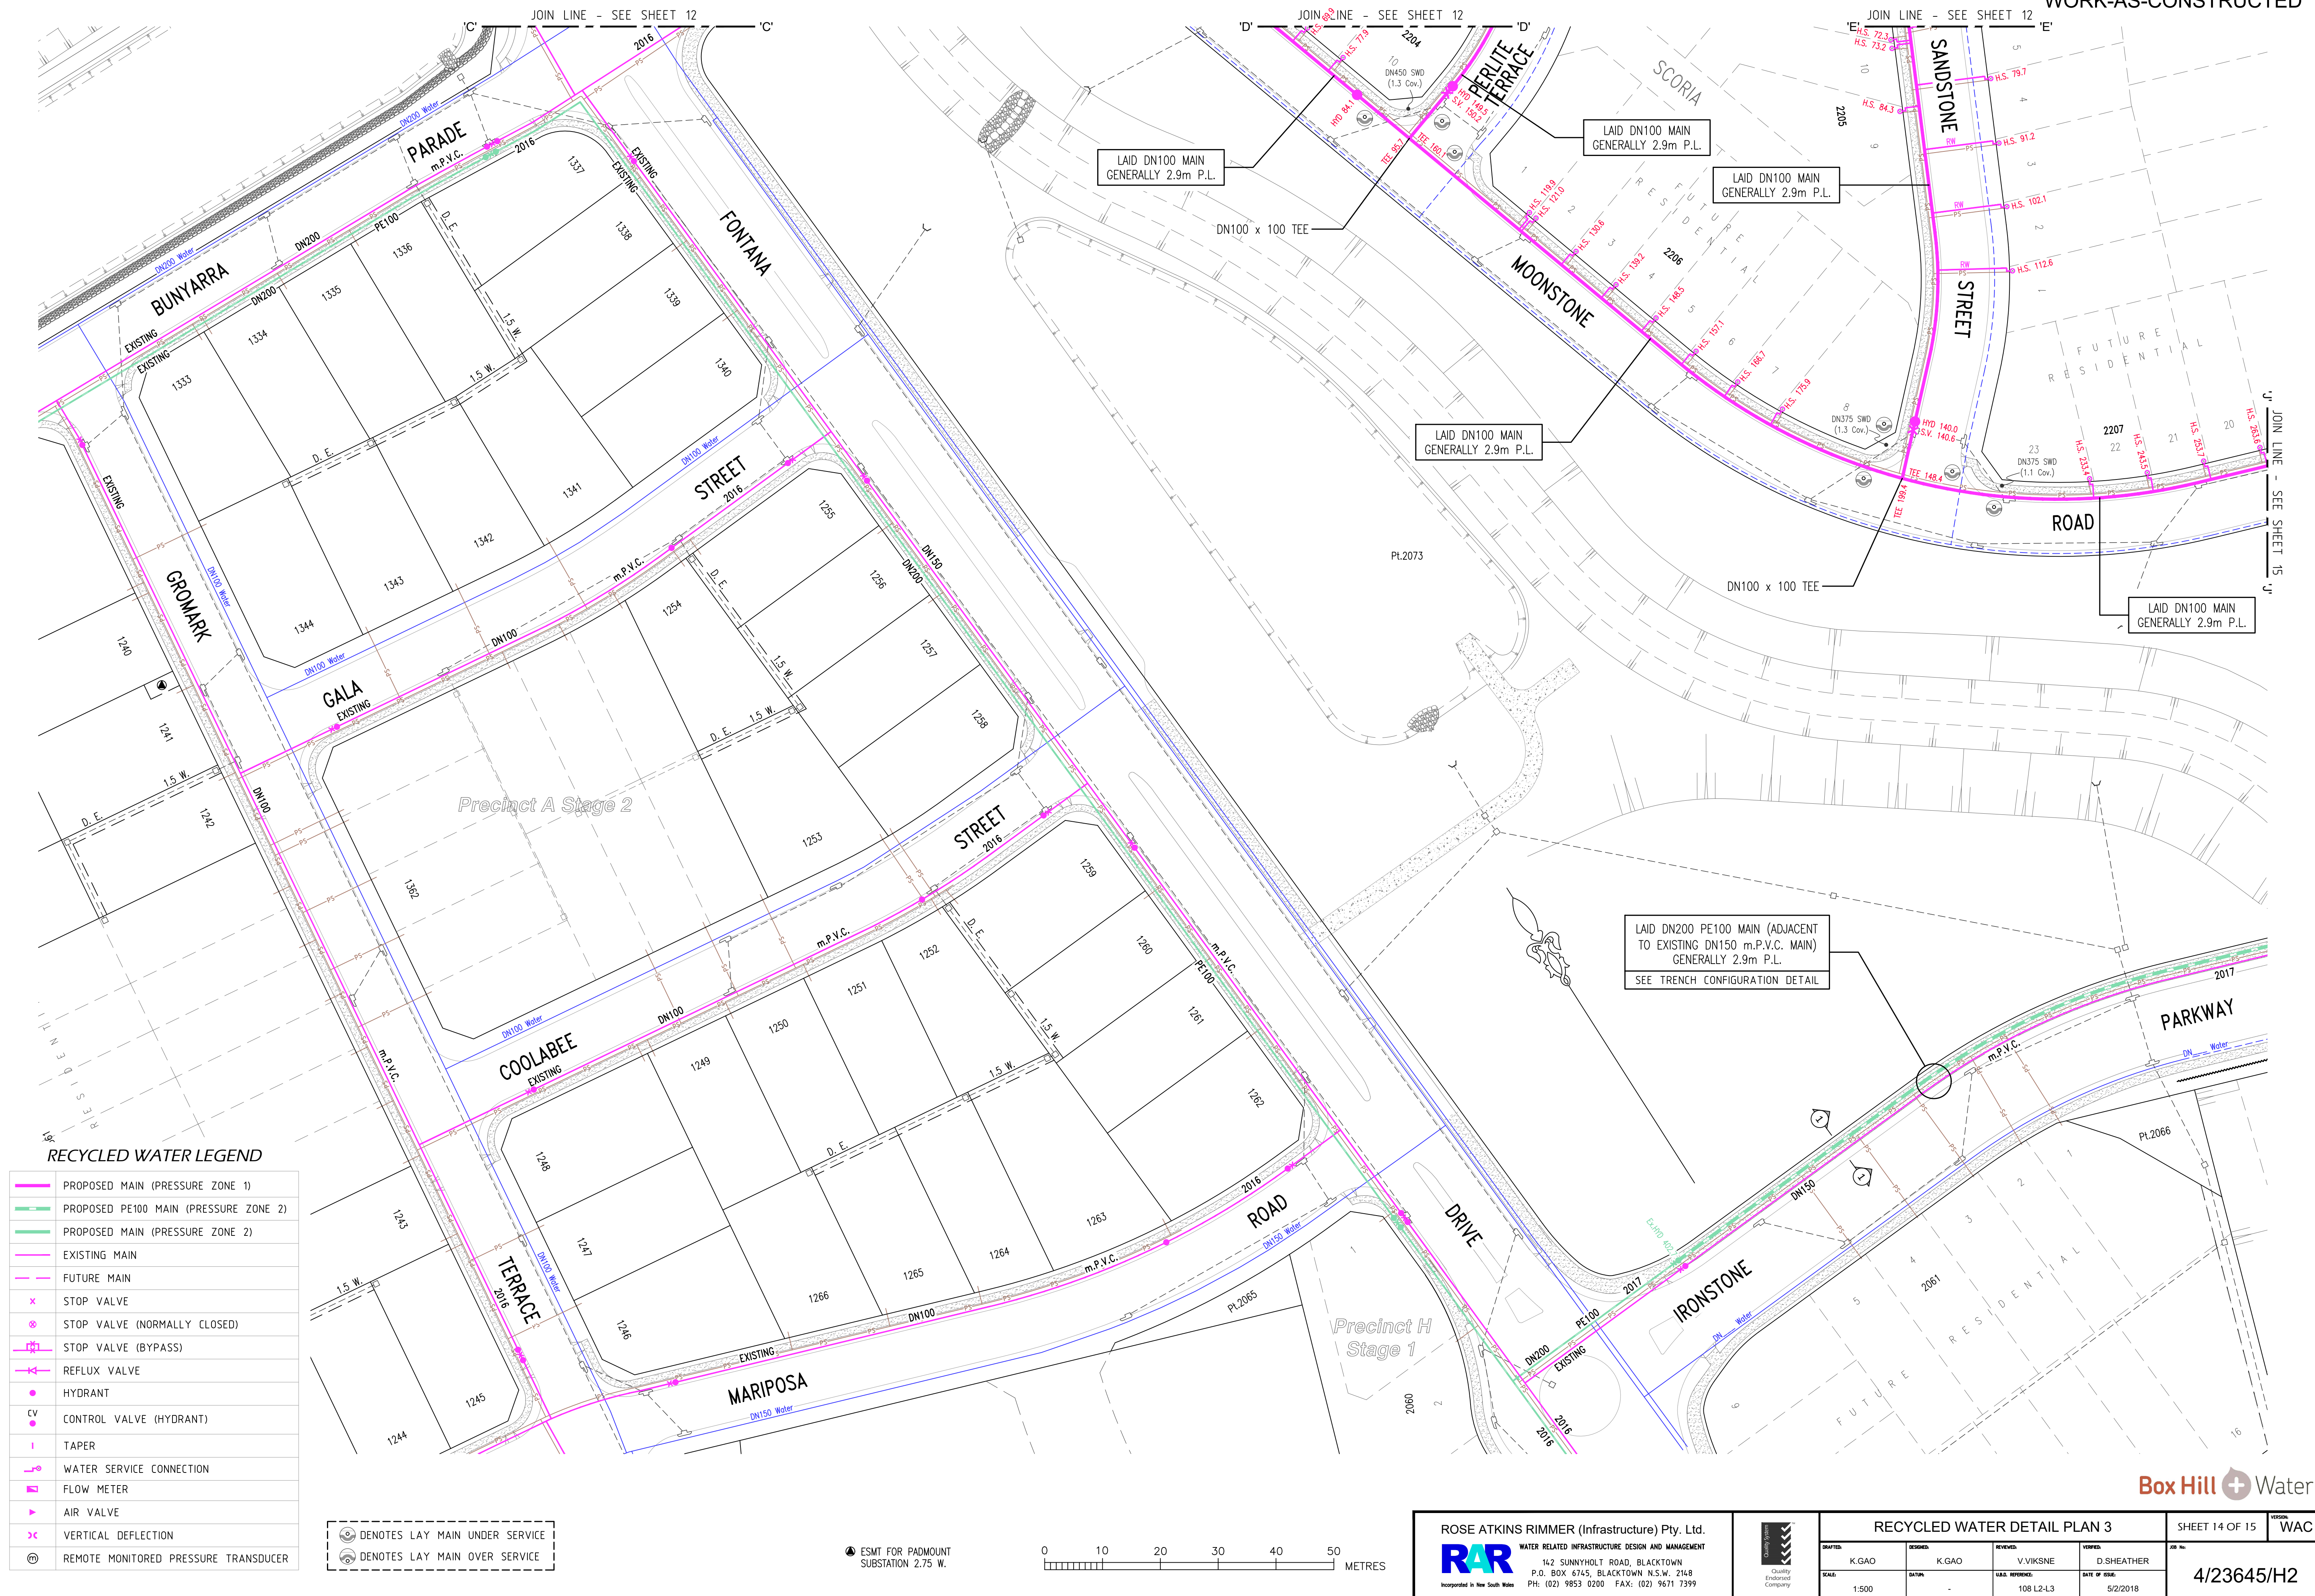

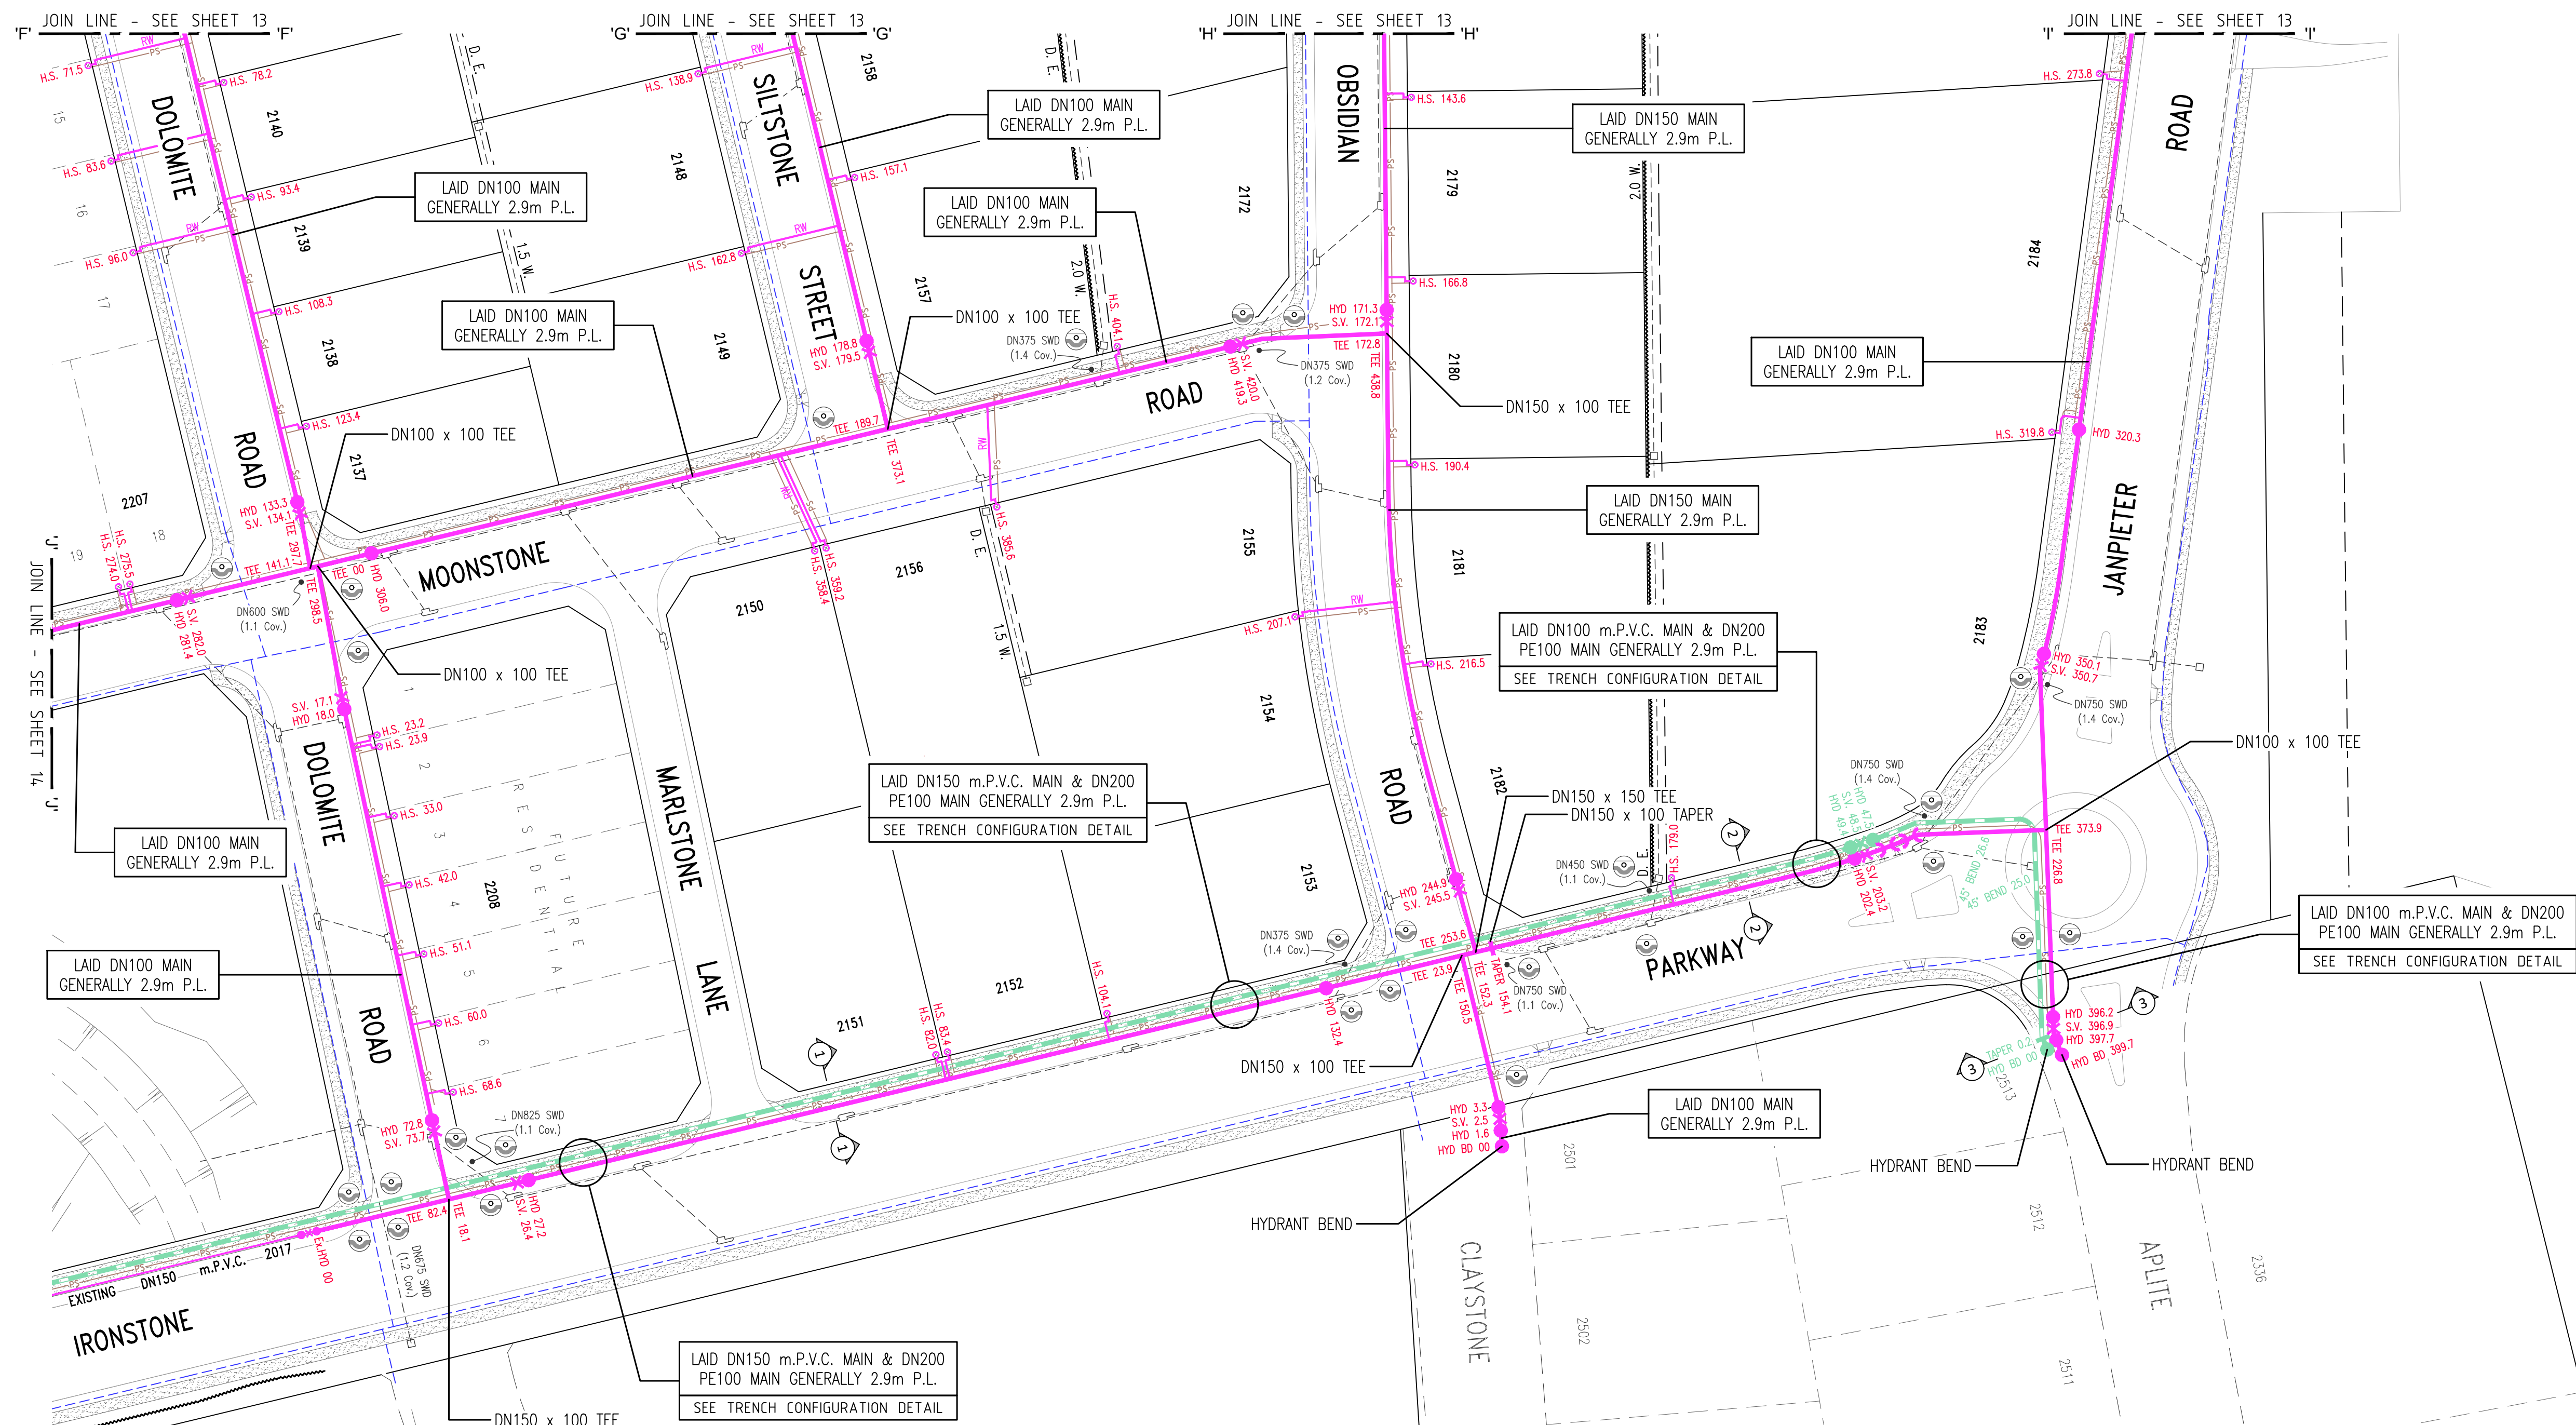

RECYCLED WATER LEGEND


	PROPOSED MAIN (PRESSURE ZONE 1)
	PROPOSED PE100 MAIN (PRESSURE ZONE 2)
	PROPOSED MAIN (PRESSURE ZONE 2)
	EXISTING MAIN
	FUTURE MAIN
	STOP VALVE
	STOP VALVE (NORMALLY CLOSED)
	STOP VALVE (BYPASS)
	REFLUX VALVE
	HYDRANT
	CONTROL VALVE (HYDRANT)
	TAPER
	WATER SERVICE CONNECTION
	FLOW METER
	AIR VALVE
	VERTICAL DEFLECTION
	REMOTE MONITORED PRESSURE TRANSDUCER

DENOTES LAY MAIN UNDER SERVICE
 DENOTES LAY MAIN OVER SERVICE

0 10 20 30 40 50 METRES


TRENCH CONFIGURATION DETAIL

SETOUT DIMENSIONS ONLY
NOT TO SCALE
(REFER 1-1)

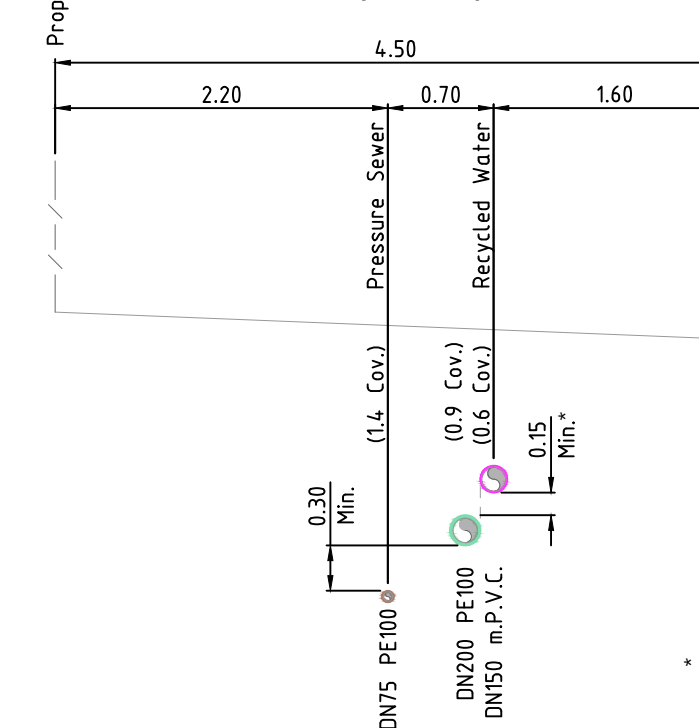

TRENCH CONFIGURATION DETAIL


SETOUT DIMENSIONS ONLY
NOT TO SCALE
(REFER 2-2, 3-3)

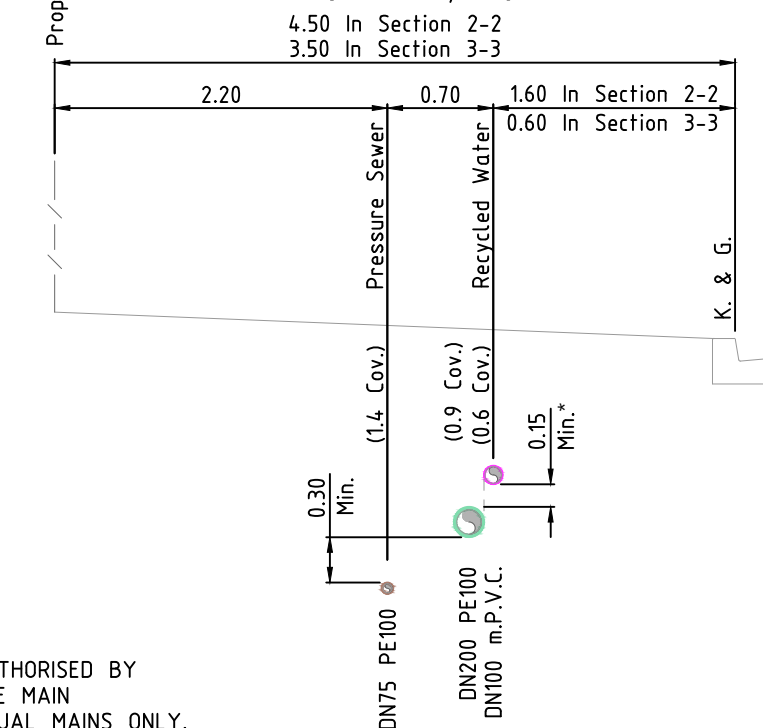

* VERTICAL CLEARANCE REDUCTION AUTHORISED BY
FLOW SYSTEMS IN INSTANCES WHERE MAIN
CONFIGURATIONS CONSIST OF TWO DUAL MAINS ONLY.

ROSE ATKINS RIMMER (Infrastructure) Pty. Ltd.

 WATER RELATED INFRASTRUCTURE DESIGN AND MANAGEMENT
 142 SUNNYHOLT ROAD, BLACKTOWN
 P.O. BOX 6745, BLACKTOWN N.S.W. 2148
 PH: (02) 9853 0200 FAX: (02) 9671 7399

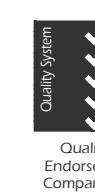

RECYCLED WATER DETAIL PLAN 4

DRAWN	DESIGNED	REVIEWED	VERIFIED
K.GAO	K.GAO	V.VIKSNE	D.SHEATHER
SCALE	DATUM	DATA REFERENCE	DATE OF ISSUE
1:500	-	108 L2-L3	5/2/2018

SHEET 15 OF 15

WAC

4/23645/H2