


REFERENCE DRAWINGS			
DISCIPLINE	DRAWING NUMBER	REV	DATE
STRUCT			
MECH			
ELEC			
RCP			
ARCH			

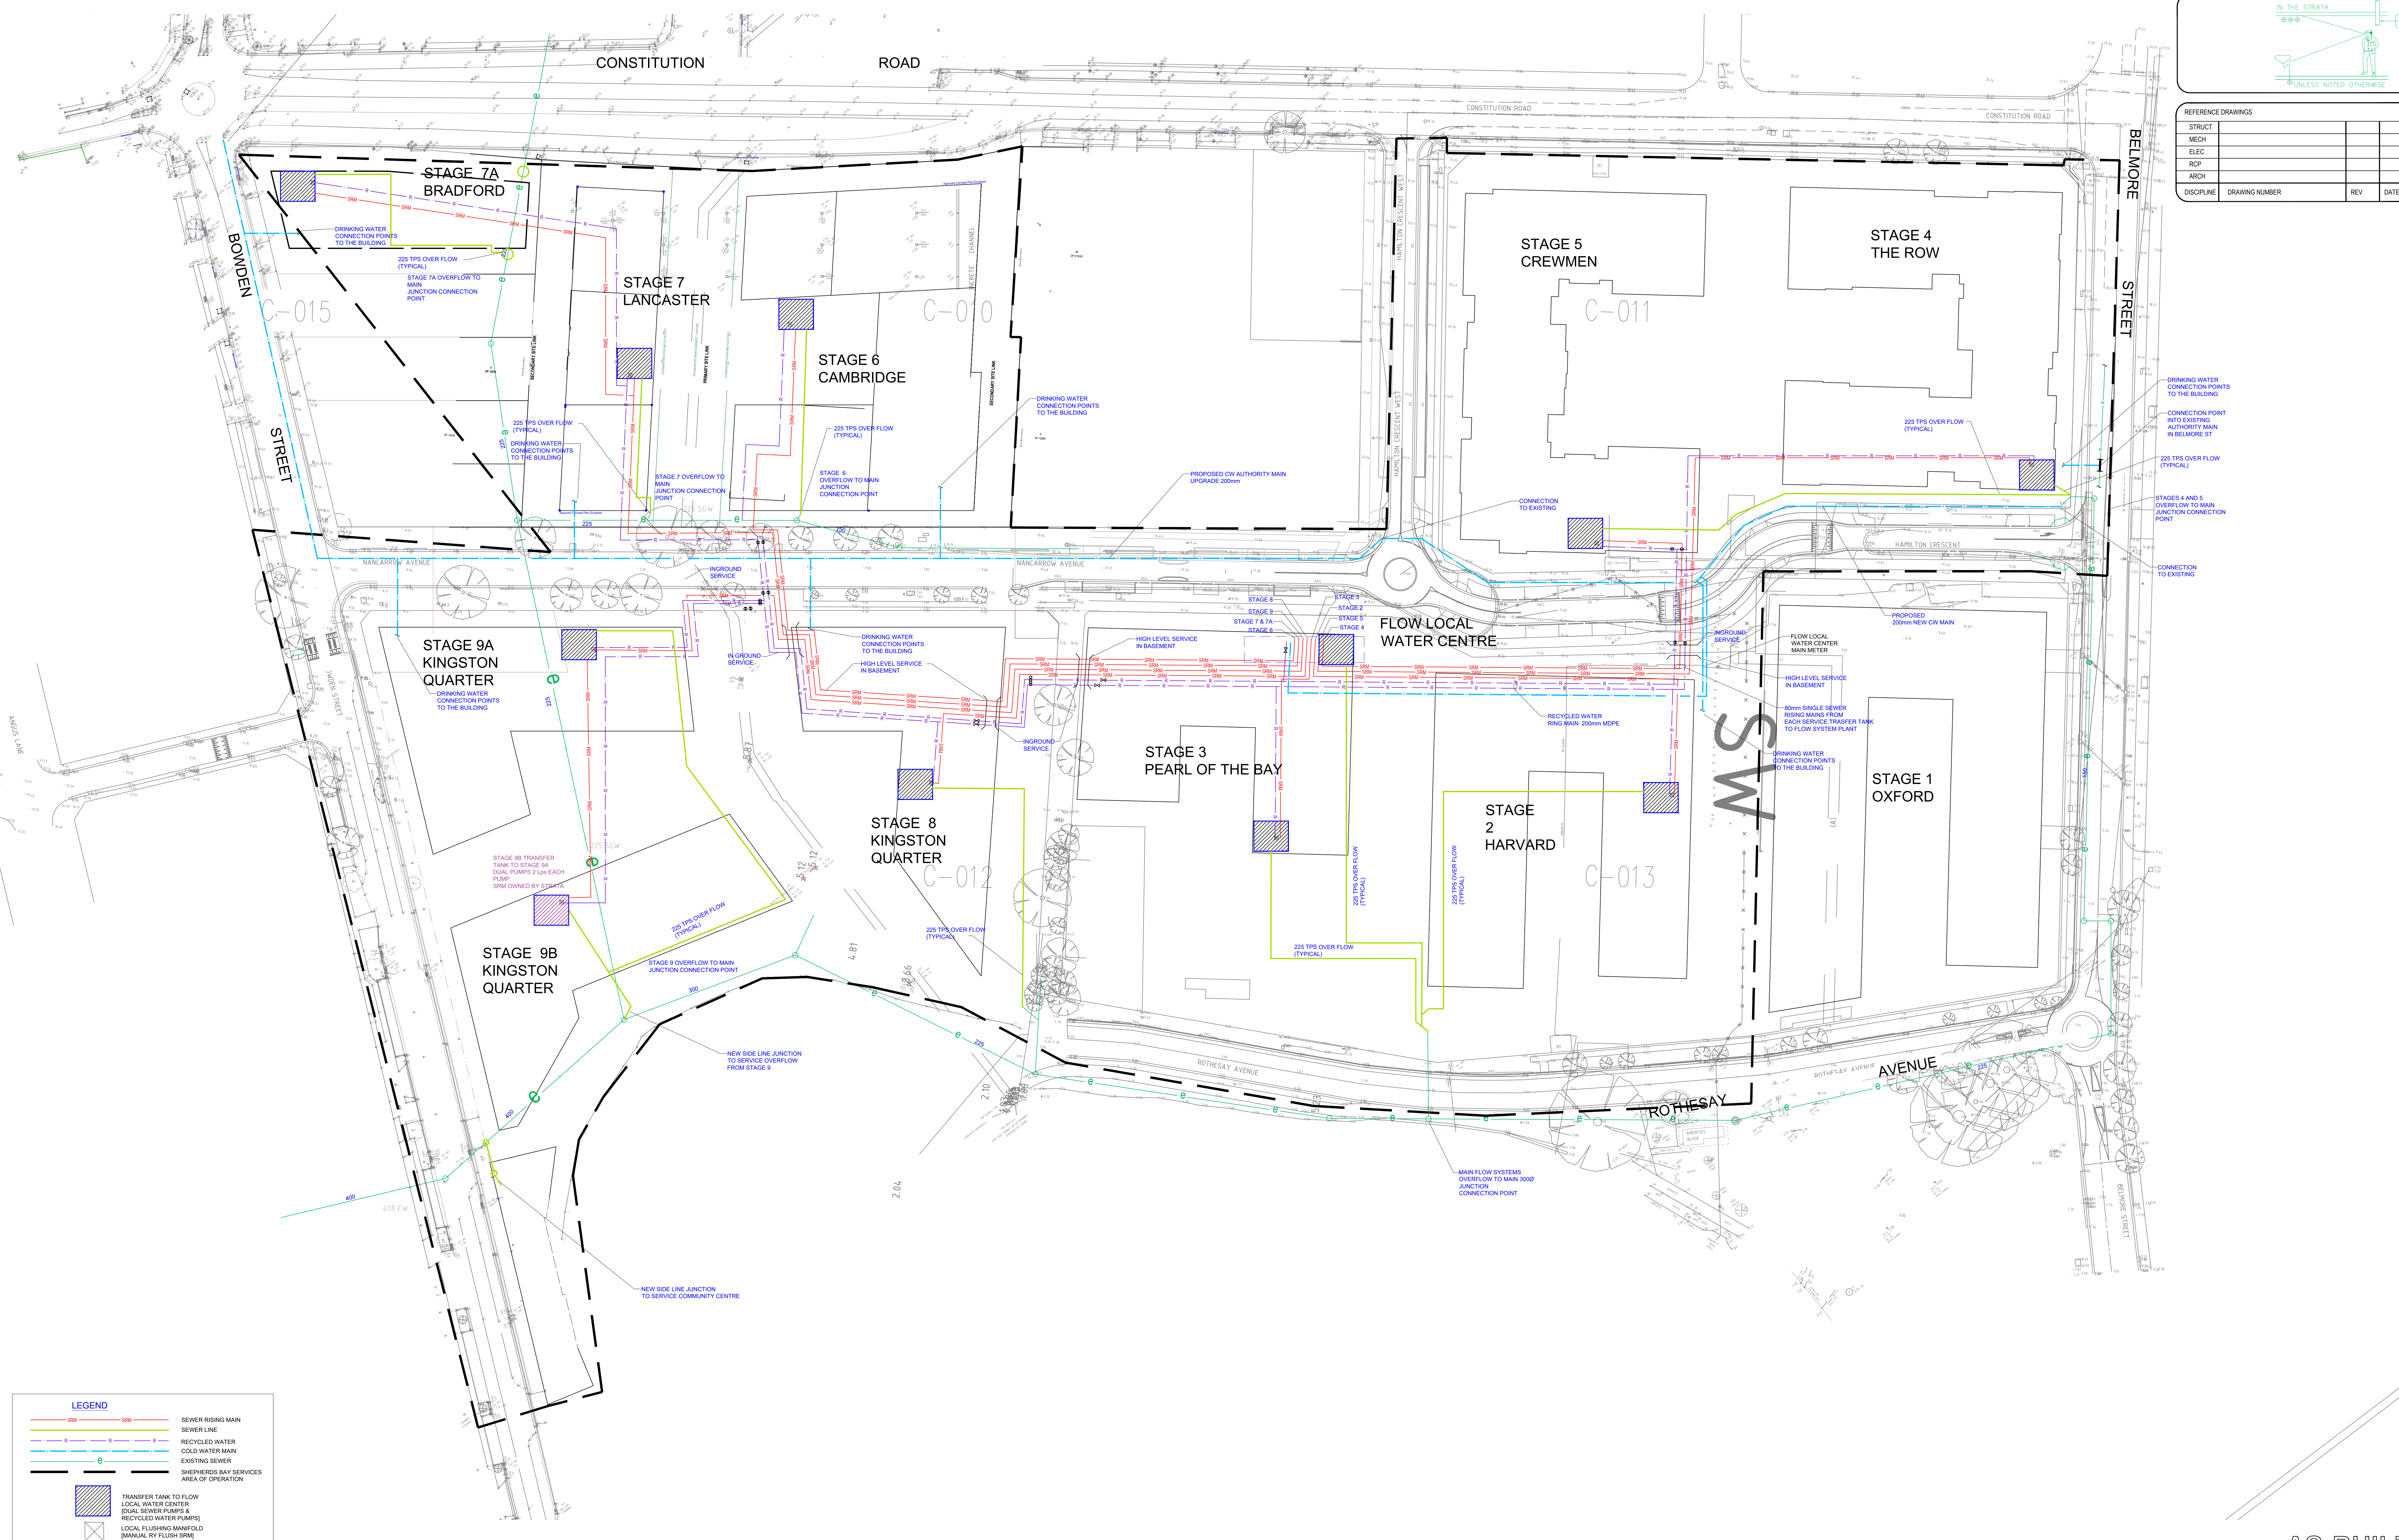


LEGEND	
	SEWER RISING MAIN
	SEWER LINE
	RECYCLED WATER
	COLD WATER MAIN
	EXISTING SEWER
	SHEPHERDS BAY SERVICES AREA OF OPERATION
	TRANSFER TANK TO FLOW LOCAL WATER CENTRE (DUAL SEWER PUMPS & RECYCLED WATER PUMPS)
	LOCAL FLUSHING MANHOLE (MANUAL BY FLUSH BRN)

AS-BUILT

REVISION	DATE	ISSUE	AMENDMENT
AB	06/06/19	REVISED AS BUILT	
AB	27/02/19	AS BUILT	

REVISION	DATE	ISSUE	AMENDMENT

ARCHITECT / PROJECT MANAGER	CLIENT

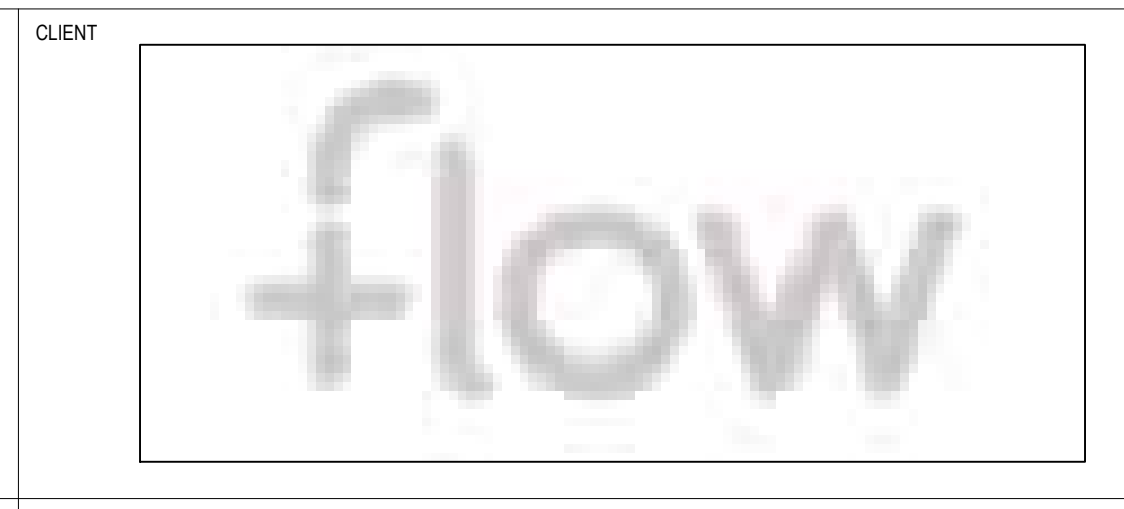

HYDRAULIC & FIRE SERVICES CONSULTANTS
 PREPARED BY
ALIGN ENGINEERING GROUP
 PO BOX 8013
 PORT MACQUARIE
 NSW 2444
 T:0403 852 312
 Email: alan.thomas.aeg@gmail.com ABN2878949310

PROJECT	SHEPHERDS BAY FLOW INFRASTRUCTURE MEADOWBANK 2114			
PROJECT No.	DATE	DRAWN	No IN SET	SCALE
AEG133	27.02.19	AT	01OF01	1:100

DRAWING TITLE	HYDRAULIC SERVICES LEVEL DRAINAGE SERVICES
DRAWING No.	FAI-100
REVISION	AB

COPYRIGHT © ALIGN ENGINEERING GROUP.
 All rights reserved. This drawing may not be reproduced or transmitted in any form, or by any means in part or in whole without permission from ALIGN ENGINEERING GROUP. Figure dimensions shall be taken in preference to scaling. The contractor shall check all dimensions on drawings and site before commencing work.